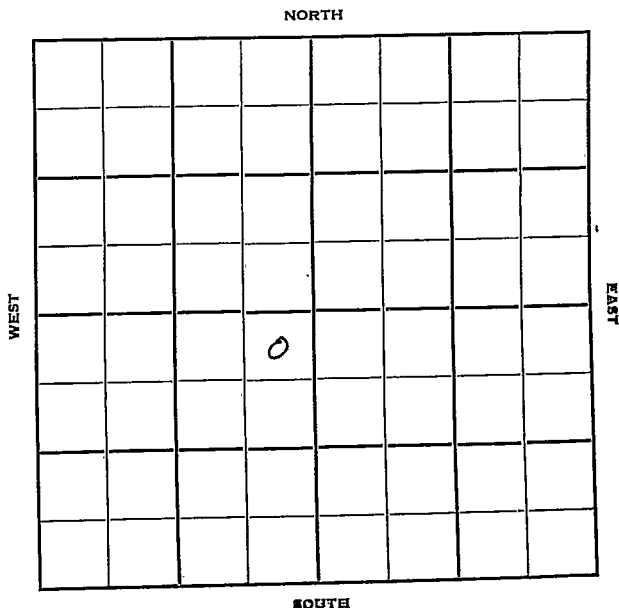


Section 8 Township 26 Range 33WWell No. #1 MowbrayCompany Champlin Ref.

Finney

KANSAS

Sec. 8 Twp. 26 R. 33W

Well No. #1 Mowbray Farm

Champlin Refg. Company

Champlin - Contr. Contractor


330' Ft. from N. Line

_____ Ft. from S. Line

330' Ft. from E. Line

_____ Ft. from W. Line

NE NE SW

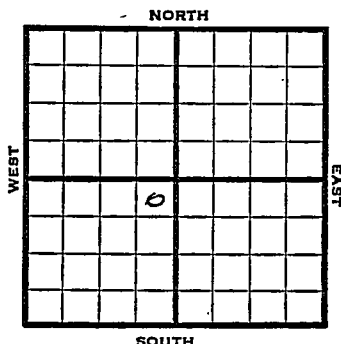

19 51

Elev. 2913'

REPORT

10/24
1952
1/9

Location

Spud 10-24-51

Gas well TD 2720

9" @ 644 7" @ 2582 TD 2720

Her. 2576 Krider 2626 Win. 2626-54

Ft. Riley 2684 24000 A

Comp. 8,352,000 gas

COMPLETED

J. E. TYRA



J. E. TYRA