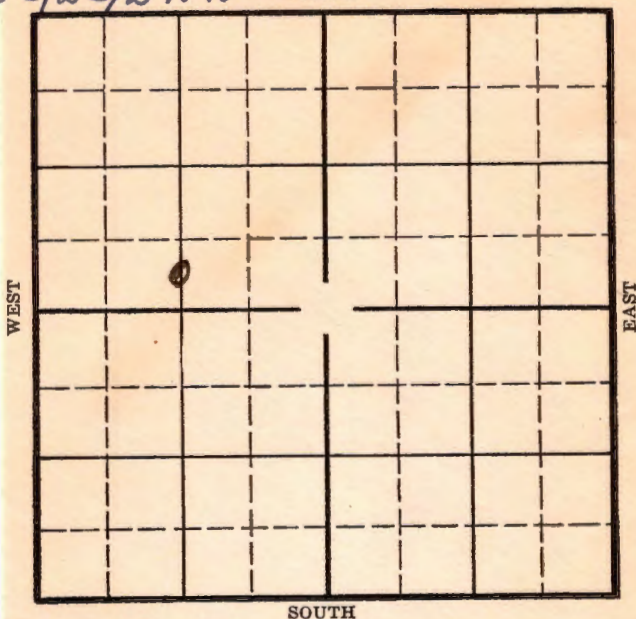


O.W.W.O.

RENO

KANSAS

Form 51-5M-3-35-Mid-West

Map No. **KANSAS** Sec. **11** Twp. **26 S** R. **9-W**Well No. **1-Nunemaker** Farm~~Shell Pot.~~ **Messman & Rinehart** company**C 5/2 S 1/2 NW** NORTHLocation _____
Drilling Remarks _____Rig Up _____
Drilling Remarks _____**RECORD**

Cased _____ in. _____ ft.

Sand _____

Gas _____

Oil _____

Total Depth _____

PRODUCTION

1st 24 hrs. Nat. _____

1st 24 hrs. after shot _____

Gas _____ cu. ft.

Dry Hole _____

Abandoned _____

O.W.W.O.

Map No. KANSAS Sec. 11 Twp. 26S R. 9W
Well No. 1- Nunemaker Farm
Shell Pet Company
Messman & Rinehart

Ft. from N. Line

440 Ft. from S. Line

1320 Ft. from E. Line

Ft. from W. Line

E S/2 S/2 NW

REPORT

1936
3/11 Rgn Rotary
3/13 Rign.
3/20 15"-270 Drlg. 1357.
3/27 12"-270' Drlg. 2840'
4/2 T.Chat 3870' Drlg. 3923'
4/10 Drlg. 4122' Viola.
4/16 T.D. 4146-1000 acid. 2935 bbls
in 6 hours flow.
4/22/36- Viola 4122'
T.D. 4146'
1000 acid. Flow 2935 BBLs in 6 HRS.
Flow 1123 bbls. P.T. 11,123 BBLs.

COMPLETED

Map No. 21 Sec. 11 Twp. 26 R. 9WWell No. 1-HaremakerShell jet. Company

Contractor

FIRST REPORTS

Ft. from N. Line

440 Ft. from S. Line1320 Ft. from E. Line

Ft. from W. Line

SECTION PLAT

Location

Rig up

Drilling and Remarks:

Rign Rotary

RECORD

Cased in., ft.

Sand

Gas

Oil

Total Depth

PRODUCTION

1st 24 hrs. Nat.

1st 24 hrs. after shot

Gas Cu. Ft.

Dry Hole

Abandoned

Date

ORVAL MANNSCHRECK

3-11-36 192

Scout

KANSAS

Op No. 41 Sec. 11 Twp. 26 R. 9W

Well No. 1 - Numemaker

Shell Pit Company _____

Contractor _____

COMPLETED

SECTION PLAT

0			

_____ Ft. from N. Line

440 Ft. from S. Line

1320 Ft. from E. Line

_____ Ft. from W. Line

Location _____

Rig up _____

Drilling and Remarks:

1000 acid
flowed 2935 bbls
in 6 hrs.

Prod. - 11, 123 bbls

THIS GAUGE
COARCE

RECORD

Cased _____ in., _____ ft.

Sand Viola 4122

Gas _____

Oil _____

Total Depth 4146

PRODUCTION

1st 24 hrs. Nat. _____

1st 24 hrs. after shot _____

Gas _____ Cu. Ft.

Dry Hole _____

Abandoned _____

Date

4-22-36 19

S. J. Lewis Scout
H.A.N.

O.W.W.O.

FORM 513 SUNRAY

County Reno Elev. 1668
 Sec. 11 Twp. 26 Rge. 9W
 Company Messman & Rinehart
 Farm Name Nunemaker No. 1

Co.

TOPS	DEPTH	LOG	DATUM	Loc. in Sec.
Anh.				C S/2 S/2 NW
TP.				1320' fel x
H.				440' fel NW
Tr.				Geol. (OWWO)
Dg.				Contr.
BL.				Co. Tools
L.	3343			Pool
K.C.				
B.K.C.				
Ce.				
C.				
M.				
M.				
K.				
Mz.				
Mo.				
V.	4131			
S.				
S.				
A.				
R.				
Pe.				
G.				
T.D.	OTD 4146			

Lse.

FIRST REPORT	
•	

No.

Date Comm. 8-22-57

Sec.

7" @ 4131 (Was Shell)

New Info - CO 3975, 4" @ 3950, WOC

T.

R.

27

O.W.W.O.

FORM 513 SUNRAY

1669 OF

County Reno

Elev. 1668

Sec. 11

Twp. 26

Rge. 9W

Company Messman & Pinehart

Farm Name Nunemaker

No. 1

TOPS	DEPTH	LOG	DATUM	Loc. in Sec.
Anh.				C S/2 S/2 NW
TP.				1320' fsl x
H.				440' fsl NW 1/4
Tr.				Geol. (OWWO)
Dg.				Contr.
BL.				Co. Tools
L.	3343			Pool
K.C.				
B.K.C.				
Ce.				
C.				
M.		3857		
M.				
K.				
Mz.				
Mq.				
V.	4131			
S.				
S.				
A.				
R.				
PE.				
G.				
TD.	OTD	4116		

COMPLETE
SEP 11 '57

Date Comm. 8-22-57

7" @ 4131 (Was Shell)

New Info - CO 3975, 1" @ ³⁹⁴⁶ ~~3950~~, WOC

SEP 4 '57

16/3859-75

SEP 11 '57

64/3869-75 250 Mda and Froc

6x6 ga 2.500 MCF pd + 22

BF1.d TP 700 CP 900

4.5 MCF 4.500 MCF

calc op flow PEPL takes Gas


Map No. _____ Sec. 11 Twp. 26 R. 9N

Well No. 146

Shell Company

Contractor

SECTION PLAT

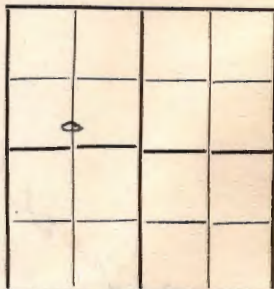

_____ Ft. from N. Line

440 Ft. from S. Line

1320 Ft. from E. Line

_____ Ft. from W. Line

COMPLETED

Location _____

Rig up _____

Drilling and Remarks: _____

Viola 4122

Flow 115

RECORD

Cased _____ in., _____ ft.

Sand _____

Gas _____

Oil _____

Total Depth 4146

PRODUCTION

1st 24 hrs. Nat. _____

1st 24 hrs. after shot _____

Gas _____ Cu. Ft.

Dry Hole _____

Abandoned _____

Date

APR 22 1922

S. J. LEWIS Scout