

KANSAS


FORM 51 5M 2-38 TPCO.

Reno

Section 11 Township 26 Range 9-W

Well No. 2 Nunemaker

Company Shell

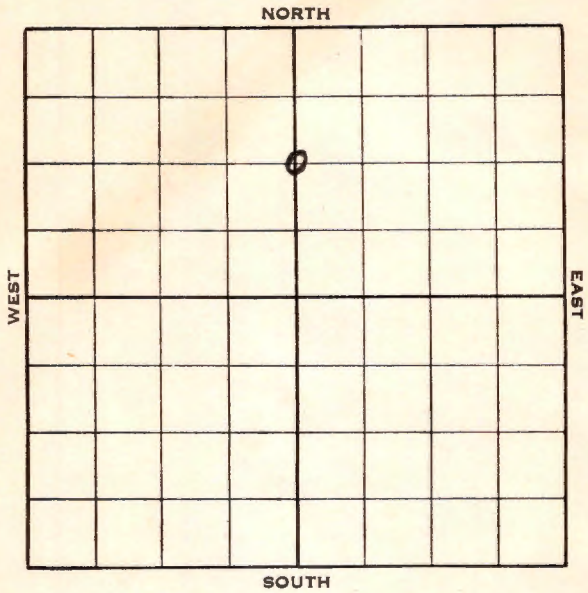

Sec. 11 Twp. 26 R. 9-W


Well No. #2 Nunemaker Farm _____
Shell Company _____

_____ Ft. from N. Line

1307 Ft. from S. Line

2620 Ft. from E. Line

_____ Ft. from W. Line

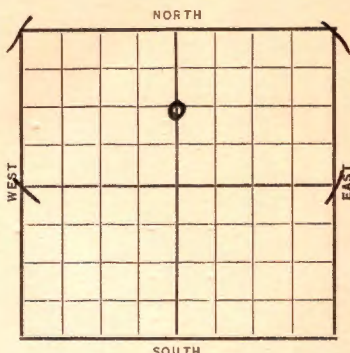

Elev. 1680

| Date | REPORT |
|------|--------------------------------------|
| 1938 | |
| 6/22 | Location |
| 7/1 | " |
| 7/8 | " |
| 7/15 | 8" - 402'. |
| 7/22 | Dlg. 2187'. |
| 7/29 | Drlg. 3150'. |
| 8/5 | Lans. 3350'. Dlg. 3723'. |
| 8/12 | Miss. 3877'. T.D. 3903'. Fsg. |
| 8/19 | SD 4050'. |
| 8/26 | Viola 4149'. Dlg. 4155'. |
| 9/2 | T. D. 4156'. S. O. 4" - 4152'. |
| | RUST. |
| 9/9 | " " " " " |
| | |
| | |
| | |
| | |
| | OVER |
| | |
| | |
| | |
| | |

1938

9/14 4" - 4152'..

Viola 4149'.

T. D. 4156'.

P. B. 4068' in Miss. Lime.

Perf. pipe 3877-3900'.

1,300,000 cu. ft. gas.

COMPLETED

Reno

Map No. 41 Sec. 11 Twp. 26 R. 9W

Well No. 2 Nunemaker

Shell

Company _____

Contractor _____

COMPLETED

C N $\frac{1}{2}$

_____ Ft. from N. Line

1307 Ft. from S. Line

2620 Ft. from E. Line

_____ Ft. from W. Line

SECTION PLAT

| | | | |
|--|--|---|--|
| | | | |
| | | ⊙ | |
| | | | |
| | | | |

Location _____

Rig up _____

Drilling and Remarks:

PB 4068 IN MISSISSIPPI
Perf. pipe
3877-3900
1,300,000 gals

RECORD

Cased 4 in., 4152 ft.

Sand 41012 4149

Gas _____

Oil _____

Total Depth 4156

PRODUCTION

1st 24 hrs. Nat. _____

1st 24 hrs. after shot _____

Gas _____ Cu. Ft.

Dry Hole _____

Abandoned _____

Date

SEP 14 1938 19

H. D. Hatfield Scout

Reno

KANSAS

Map No. 41 Sec. 11 Twp. 26 R. 9W

Well No. 2 Nunemaker

Shell Company

Contractor

FIRST REPORT

C N $\frac{1}{2}$


 Ft. from N. Line

1307 Ft. from S. Line

2620 Ft. from E. Line

 Ft. from W. Line

SECTION PLAT

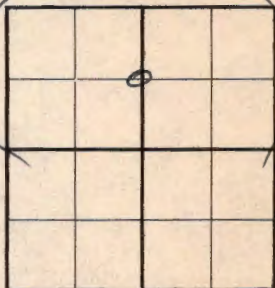

Location X

Rig up

Drilling and Remarks:

RECORD

Cased in., ft.

Sand

Gas

Oil

Total Depth

PRODUCTION

1st 24 hrs. Nat.

1st 24 hrs. after shot

Gas Cu. Ft.

Dry Hole

Abandoned

Date

JUN 22 1938 19 H. D. Hatfield Scout