


Map No. **KANSAS** Sec. 11 Twp. 26 R. 9 W

Well No. 1-Receipt Farm \_\_\_\_\_  
Shell Pit Company \_\_\_\_\_

NORTH

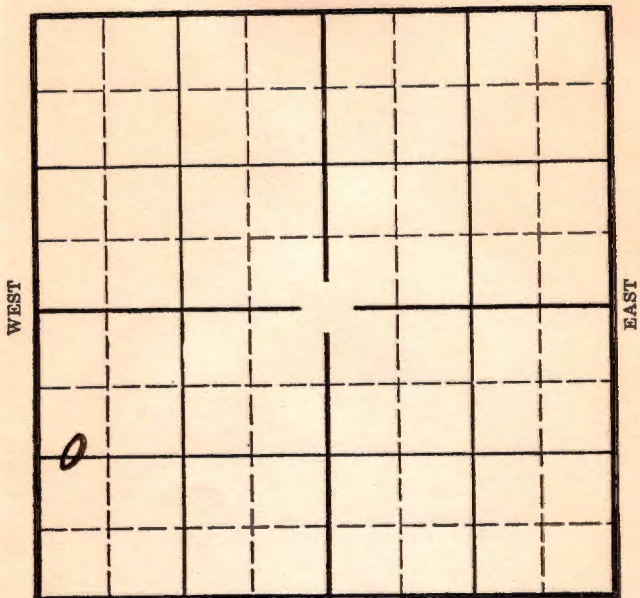

SOUTH

Location \_\_\_\_\_

Drilling Remarks \_\_\_\_\_

\_\_\_\_\_

\_\_\_\_\_

Rig Up \_\_\_\_\_

Drilling Remarks \_\_\_\_\_

\_\_\_\_\_

\_\_\_\_\_

RECORD

Cased \_\_\_\_\_ in. \_\_\_\_\_ ft.

Sand \_\_\_\_\_

Gas \_\_\_\_\_

Oil \_\_\_\_\_

Total Depth \_\_\_\_\_

PRODUCTION

1st 24 hrs. Nat. \_\_\_\_\_

1st 24 hrs. after shot \_\_\_\_\_

Gas \_\_\_\_\_ cu. ft. \_\_\_\_\_

Dry Hole \_\_\_\_\_


Abandoned \_\_\_\_\_

*Reno 9<sup>th</sup>*

Map No.            Sec. 11 Twp. 26 R.           

Well No. 1 - Reese Farm             
Shell Pet. Company           

Ft. from N. Line             
1370 Ft. from S. Line             
Ft. from E. Line             
330 Ft. from W. Line             
**Elev. 1677**

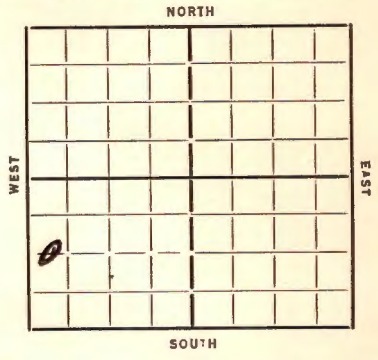

Date	REPORT
<i>7/17</i>	<i>Location</i>
<i>8/8</i>	<i>dly 1965</i>
<i>8/15</i>	<i>2667</i>
<i>8/22</i>	<i>Coring 3333</i>
<i>8/29</i>	<i>N @ V 3345 Coring 3358 No.</i>
<i>9/6</i>	<i>3525 No <del>3519</del> 70 3515-19</i>
<i>10/3</i>	<i>BML 3950 TV 4128</i>
	<i>4137-56 Drill stem test</i>
	<i>Shows 23 Oil &amp; 3 Water</i>
<i>10/10</i>	<i>Bailing</i>
<i>10/21</i>	<i>Top Hole 4128</i>
	<i>Top Oil 4137-56</i>
	<i>Set 8" 4135</i>
	<i>While drilling cement lost</i>
	<i>barrel in hole</i>
	<i>Spuzzing oil 1 mkg 1 m Gas</i>
	<i>Now fog binder (20)</i>

(OVER)

10/24 Top Viola 4128

Show Oil 4137-56

8" 4135

Est 1 M Gas

Well flowed 878 Bbls last  
24 hrs No Water

Has not been acidized (Tel)

10/25 Well flowed 874 Bbls  
in 24 hrs

Bailer still in hole

This is a Viola lime well (Tel)

11/1 pumped 878 - 24 hrs.

11/13 Viola 4128

Oil 4137-56

TD 4156

flow 878 Bbls.

COMPLETED

Map No. 41 Sec. 11 Twp. 26 R. 9W

Well No. 1- Reese

Shell pit Company

Contractor

COMPLETED

SECTION PLAT

..... Ft. from N. Line

1320 Ft. from S. Line

..... Ft. from E. Line

330 Ft. from W. Line


Location.....

Rig up.....

Drilling and Remarks:

flow  
878 bbls

RECORD

Cased..... in., ..... ft.

Sand Viola 4128

Gas.....

Oil 4137-56

Total Depth 4156

PRODUCTION

1st 24 hrs. Nat.....

1st 24 hrs. after shot.....

Gas..... Cu. Ft.

Dry Hole.....

Abandoned.....

Date

11-13-35 192

ORVAL MANNSCHRECK

Scout

No. 41 Sec. 11 Twp. 26 R. 9W

No. 1- Reese

shell pit. Company

Contractor

FIRST REPORTS

SECTION PLAT

Ft. from N. Line

1320 Ft. from S. Line

Ft. from E. Line

330 Ft. from W. Line


Location

Rig up

Drilling and Remarks:

RECORD

Cased..... in., ..... ft.

Sand.....

Gas.....

Oil.....

Total Depth.....

PRODUCTION

1st 24 hrs. Nat.....

1st 24 hrs. after shot.....

Gas..... Cu. Ft.

Dry Hole.....

Abandoned.....

Date

7-17-35 192

ORVAL MANNSCHECK

Scout