


Reno
26 9W

KANSAS

Map No. _____ Sec. 11 Twp. 26 R. 9W

Well No. 2-Reece Farm _____
Shell Company _____

440 Ft. from N. Line
____ Ft. from S. Line
1320 Ft. from E. Line
____ Ft. from W. Line

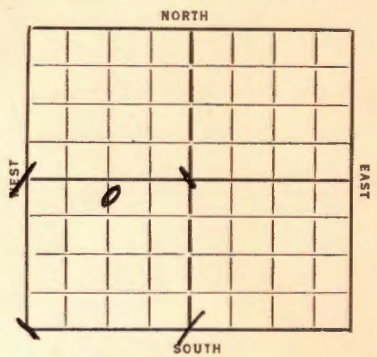

Elev. 1675

REPORT

1936
1/22 Rot rig & M J Tools.
1/31 dly 1559 12" 256
2/7 & 3321
2/14 TIC 3344 so 3440-45
Chat 3876
dly 3918
2/21 Miss 3958 Viola 4135
so 4144 TD 4152
7" 4135 WOC
2/28 dly plug
3/4 Viola 4135
TD 4152
1000 acid
3000 "
5455 lbs flowing

COMPLETED

Map No. 41 Sec. 11 Twp. 26 R. 9W

Well No. 2 - Bee

Shell petroleum Company

Contractor

COMPLETE

SECTION PLAT

440 Ft. from N. Line

..... Ft. from S. Line

1320 Ft. from E. Line

..... Ft. from W. Line

	0		

Location.....

Rig up.....

Drilling and Remarks:

1000 acid
3000 acid

5455 bbls

flowing

RECORD

Cased..... in., ft.

Sand Viola 4135

Gas.....

Oil.....

Total Depth 4152

PRODUCTION

1st 24 hrs. Nat.....

1st 24 hrs. after shot.....

Gas..... Cu. Ft.

Dry Hole.....

Abandoned.....

Date

ORVAL MANNSCHRECK

3-4-36 192.....

Scout

Map No. 41 Sec. 11 Twp. 26 R. 9W

Well No. 2 - Reece

Shell Company

Contractor

SECTION PLAT


440 Ft. from N. Line

..... Ft. from S. Line

1320 Ft. from E. Line

..... Ft. from W. Line

FIRST REPORT

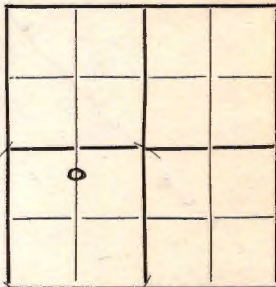

Location.....

Rig up.....

Drilling and Remarks:

*Rot Rig +
mov. in tools*

RECORD

Cased.....in.,ft.

Sand.....

Gas.....

Oil.....

Total Depth.....

PRODUCTION

1st 24 hrs. Nat.....

1st 24 hrs. after shot.....

Gas.....Cu. Ft.

Dry Hole.....

Abandoned.....

Date

JAN 22 1936

192

Scout

ORVAL MANSCHRECK