


Section 11 Township 26 Range 9-W

Well Number #3-Reece

Company Shell

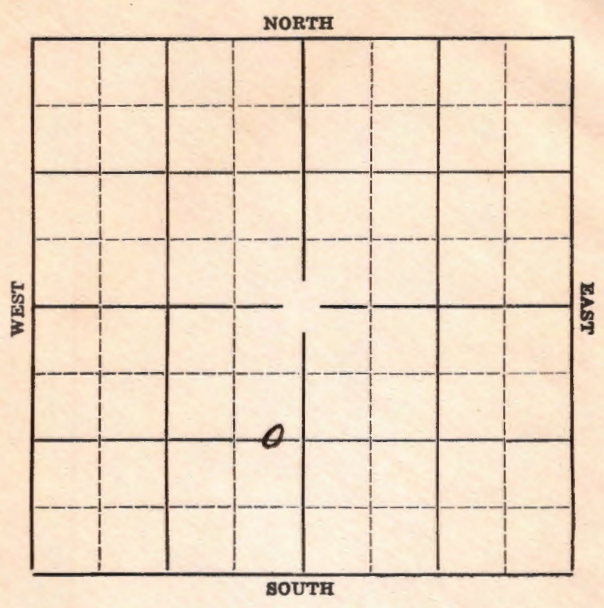

Map No. 41 Sec. 11 Twp. 26 R. 9W

Well No. 2 RECCU

Shell Company

Contractor

SECTION PLAT

_____ Ft. from N. Line

1308 Ft. from S. Line

420 Ft. from E. Line

_____ Ft. from W. Line

COMPLETED

Location _____

Rig up _____

Drilling and Remarks:

*Vista 4121.
2000 acid
P 8820*

RECORD

Cased _____ in., _____ ft.

Sand _____

Gas _____

Oil _____

Total Depth 4124

PRODUCTION

1st 24 hrs. Nat. _____

1st 24 hrs. after shot _____

Gas _____ Cu. Ft.

Dry Hole _____

Abandoned _____

Date

NOV 18 1936 19

S. J. LEWIS Scout

KANSAS

Map No. 41 Sec. 11 Twp. 26 R. 9W

Well No. 3 Pecee

Bell Company

Contractor

SECTION PLAT

		6	

_____ Ft. from N. Line

1308 Ft. from S. Line

420 Ft. from E. Line

_____ Ft. from W. Line

FIRST REPORT

Location _____

Rig up _____

Drilling and Remarks:

Rigging up.

RECORD

Cased _____ in., _____ ft.

Sand _____

Gas _____

Oil _____

Total Depth _____

PRODUCTION

1st 24 hrs. Nat. _____

1st 24 hrs. after shot _____

Gas _____ Cu. Ft.

Dry Hole _____

Abandoned _____

Date

SEP 9 1936 19

S. J. LEWIS

Scout