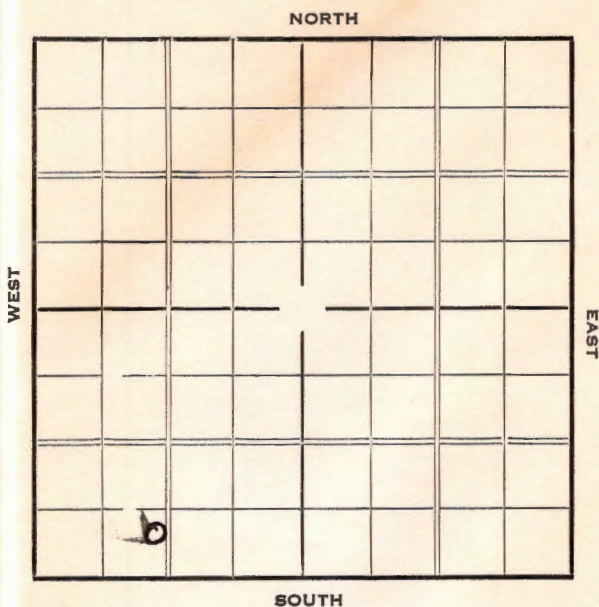


KANSAS

RENO

Section 11 Township 26 Range 9WWell Number 4 ReeceCompany Shell

Sec. 11 Twp. 26 R. 9-W

Well No. #4 Reece Farm
Shell Company


Ft. from N. Line

440 Ft. from S. Line

Ft. from E. Line

1299 Ft. from W. Line

Elev. 1670

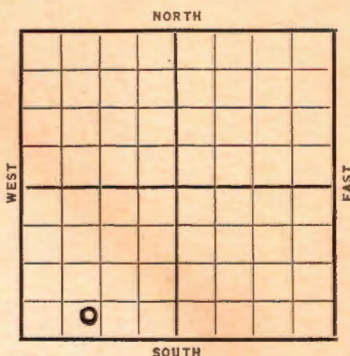

Date	REPORT
1/20	Rig.
1/28	10" @ 187'. WOC.
2/4	Drlg. 2565'.
2/11	KCL 3330'. CHAT. 3857. Drlg. 3871
2/18	Viola 4135' set 7". WOC.
2/26	TD 4138'. 1000 acid 470 bbls
	3 hrs on Potential
3/3	Viola 4135'.
	T. D. 4138'.
	Potential 3780 flow.
	COMPLETED

KANSAS

Map No. 41 Sec. 11 Twp. 26 R. 9WWell No. 4 ReeceShell Company

Contractor

SECTION PLAT

 Ft. from N. Line440 Ft. from S. Line Ft. from E. Line1299 Ft. from W. Line

FIRST REPORT

Location Rig up

Drilling and Remarks:

Rig

RECORD

Cased in., ft.Sand Gas Oil Total Depth

PRODUCTION

1st 24 hrs. Nat. 1st 24 hrs. after shot Gas Cu. Ft.Dry Hole Abandoned

Date

JAN 20 1937

19

S. J. LEWIS

Scout

Map No. 41 Sec. 11 Twp. 26 R. 9WWell No. 4 ReeseShell Company

Contractor

SECTION PLAT

 Ft. from N. Line440 Ft. from S. Line Ft. from E. Line1299 Ft. from W. Line

COMPLETED

Location Rig up

Drilling and Remarks:

Viola 4135
Potential
3780 Flow

RECORD

Cased in., ft.Sand Gas Oil Total Depth 4138

PRODUCTION

1st 24 hrs. Nat. 1st 24 hrs. after shot Gas Cu. Ft.Dry Hole Abandoned

Date

MAR 3 1937 19

S. J. LEWIS Scout