

KANSAS

Reno

Section 11 Township 26 Range 9WWell No. 1 Boroughs (Burroughs)Company Huber

NORTH

WEST

EAST

SOUTH

0

Sec. 11 Twp. 26 R. 9-W

Well No. #1 Borough Farm

Huber Company

Lebado Pool


 Ft. from N. Line

990 Ft. from S. Line

 Ft. from E. Line

990 Ft. from W. Line

NE SW NE

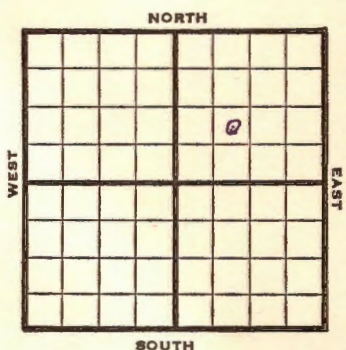

1948 **Eli 1675'** REPORT

8/11	10" @ 154'
	WOC
8/18	Tophka 2772'
	D rlg 2818'
8/25	Lansing 3327
	Mississippi 3875
	TD 3880'
	5" @ 3878'
9/1	"
9/8	"
9/14	"
9/21	"
9/29	"
10/6	"
10/13	"
10/20	TD 3880'
	Mississippi 3875'
	Aband.
	ABANDONED.

Map No. 41 Sec. 11 Twp. 26 R. 9W

Well No. 1 Boroughs

Huber

Company

ABANDONED

Contractor

NE SW NE


E111675
SECTION PLAT

Ft. from N. Line

990 Ft. from S. Line

Ft. from E. Line

990 Ft. from W. Line

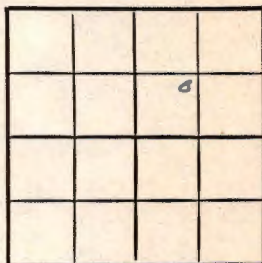

Reno County

RECORD

Location

Cased _____ in., _____ ft.

Rig up

Sand _____

Drilling and Remarks:

Gas _____

Oil _____

Total Depth 3880

PRODUCTION

1st 24 hrs. Nat. _____

1st 24 hrs. after shot _____

Gas _____ Cu. Ft.

Dry Hole _____

Abandoned _____

Date

OCT 20 1948

S. J. LEWIS


Scout

Reno County Kansas StateMap No. _____ Sec. 11 Twp. 26 R. 9WWell No. 1 BoroughsHuber Company

FIRST REPORT Contractor

NE SW NE

SECTION PLAT

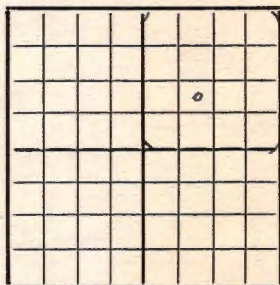

_____ Ft. from N. Line

990 Ft. from S. Line

_____ Ft. from E. Line

990 Ft. from W. LineLerado Pool

Remarks:

10" @ 154 WOC

Date
AUG 11 1948

Scout S. J. LEWIS