

Form 252-A-5M-7-36-Palace **KANSAS** Reno

Sec. 11 Twp. 26 R. 9-W

Well No. 5 Reece Farm
Shell Company


_____ Ft. from N. Line

440 Ft. from S. Line

_____ Ft. from E. Line

440 Ft. from W. Line

Elev. 1676

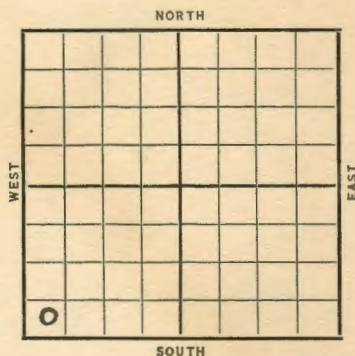

<u>1937</u>	REPORT
<u>2/17</u>	Location
<u>2/26</u>	Rig
<u>3/4</u>	10" @ 181. Drlg. 1345'.
<u>3/11</u>	Drlg. 2949'
<u>3/18</u>	TD 3227' bad hole. Plug back 2600' drlg.
<u>3/25</u>	" "
<u>4/2</u>	Drlg. 3344'.
<u>4/8</u>	Drlg. 3921'
<u>4/16</u>	Viola 4133' set 7". WOC.
<u>4/21</u>	Viola 4133'. T.D. 4140'. 2000 acid. Potential 3999.

COMPLETED

Form 51-5M-12-36 Com'l


KANSAS

Reno

Section 11 Township 26 Range 9-W

Well Number 5 Reece

Company Shell

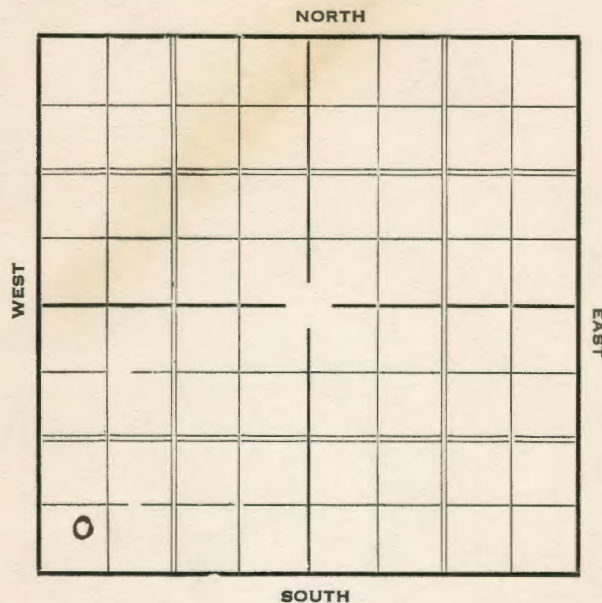

KANSAS

Reno.

Map No. _____ Sec. 11 Twp. 26 R. 9WWell No. 5 ReeceShell Company

Contractor

SECTION PLAT

_____ Ft. from N. Line

440 Ft. from S. Line

_____ Ft. from E. Line

440 Ft. from W. Line

COMPLETED

0			

Location _____

Rig up _____

Drilling and Remarks:

Viola 41332000 acidPotential8999

RECORD

Cased _____ in., _____ ft.

Sand _____

Gas _____

Oil _____

Total Depth 4140

PRODUCTION

1st 24 hrs. Nat. _____

1st 24 hrs. after shot _____

Gas _____ Cu. Ft.

Dry Hole _____

Abandoned _____

Date

APR 21 1937S. J. LEWIS

Scout

KANSAS

Map No. 41 Sec. 11 Twp. 26 R. 9WWell No. 5 ReeceShell Company

Contractor

SECTION PLAT

_____ Ft. from N. Line

440 Ft. from S. Line

_____ Ft. from E. Line

440 Ft. from W. Line

FIRST REPORT

0			

Location ✓

Rig up _____

Drilling and Remarks:

RECORD

Cased _____ in., _____ ft.

Sand _____

Gas _____

Oil _____

Total Depth _____

PRODUCTION

1st 24 hrs. Nat. _____

1st 24 hrs. after shot _____

Gas _____ Cu. Ft.

Dry Hole _____

Abandoned _____

Date

FEB 17 1937

19

S. J. LEWIS

Scout