

Sec. 11 Twp. 26 R. 9W ✓

Well No. #2-A Reece Farm _____

Huber Company _____

Lerado Pool


990' Ft. from N. Line

_____ Ft. from S. Line

990' Ft. from E. Line

_____ Ft. from W. Line

SW NE SW

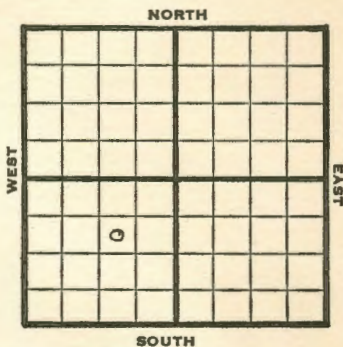


1948	REPORT
	Eli 1666'
7/14	RUR
7/21	10" @ 200' Drlg 1975'
7/28	Lansing 3304' Drlg 3515'
8/4	Mississippi 3849' Viola 4122' Simpson sand 4208' Drlg. 4256'
8/11	Arb. 4343-47' TD 4347' 5" @ 4170'
8/18	"
8/25	"
9/1	"
9/8	"
9/14	"
9/21	"
9/29	"
10/6	"
10/13	"
10/20	TD 4347' Arb. 4343' Aband. ABANDONED

Section 11 Township 26 Range 9-W

Well No. #2-A Reece

Company Huber

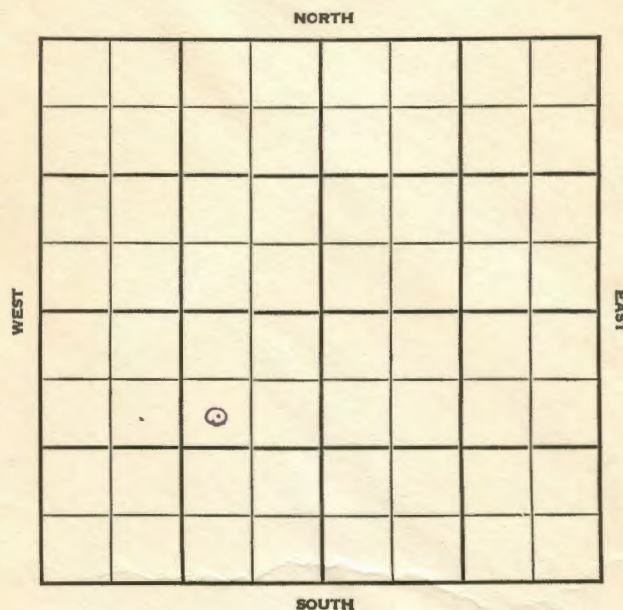

Form 26-200 Bks.-1-48-Palace
Kansas

Lerado Pool

Map No. _____ Sec. 11 Twp. 26 R. 9W

Well No. 2 - A Reece

Huber _____ Company

FIRST REPORT

Contractor

SW NE SW

SECTION PLAT

990 Ft. from N. Line

_____ Ft. from S. Line

990 Ft. from E. Line

_____ Ft. from W. Line

Reno County

Location _____

Rig up _____

Drilling and Remarks:

R U R

RECORD

Cased _____ in., _____ ft.

Sand _____

Gas _____

Oil _____

Total Depth _____

PRODUCTION

1st 24 hrs. Nat. _____

1st 24 hrs. after shot _____

Gas _____ Cu. Ft.

Dry Hole _____

Abandoned _____

Date

JUL 14 1948 19

S. J. LEWIS Scout

Form 26 200 Bks. 9-48 Petrol
Kansas

Lerado Pool

Map No. 41 Sec. 11 Twp. 26 R. 9W

Well No. 2 - A Reece

Huber _____ Company

ABANDONED

Contractor

SW NE SW

SECTION PLAT

990 Ft. from N. Line

_____ Ft. from S. Line

990 Ft. from E. Line

_____ Ft. from W. Line

Reno County

Location _____

Rig up _____

Drilling and Remarks:

Ar 4343

RECORD

Cased _____ in., _____ ft.

Sand _____

Gas _____

Oil _____

Total Depth _____

PRODUCTION

1st 24 hrs. Nat. _____

1st 24 hrs. after shot _____

Gas _____ Cu. Ft.

Dry Hole _____

Abandoned _____

Date

OCT 20 1948 19

S. J. LEWIS Scout