

KANSAS

Reno

Map No. _____ Sec. 14 Twp. 26 R. 9-W

Well No. #3 Whipple Farm _____
Shell Company _____


440 Ft. from N. Line

_____ Ft. from S. Line

_____ Ft. from E. Line

1299 Ft. from W. Line

Elev. 1660

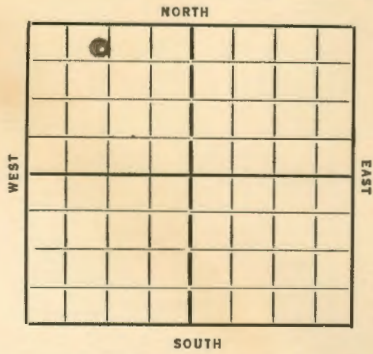

REPORT

Date	REPORT
1936	
12/22	Rigging up
12/29	13" @ 180 WOC.
1937	
1/7	Drlg. 3413'.
1/14	Drlg. 3810'.
1/21	Chat 3860'. Viola 4121'. Coring 4127'.
1/28	T. D. 4127'. Pot. 3759 bbls.
2/3	Chat 3860'. Viola 4121'. T. D. 4127'. 2000 acid. Potential 6129 oil trace water
	COMPLETED


Reno

KANSAS

Section 14 Township 26 Range 9-W

Well Number 3 Whipple

Company Shell

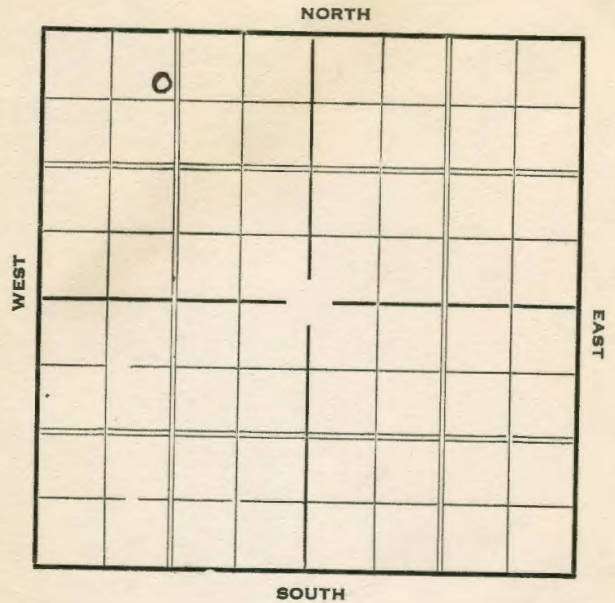

Form 26—1M Bks.—2-29 **KANSAS**
 Map No. 41 Sec. 14 Twp. 26 R. 9W
 Well No. 3 Whipple
Shell Company
 Contractor

SECTION PLAT

440 Ft. from N. Line
 _____ Ft. from S. Line
 _____ Ft. from E. Line
1299 Ft. from W. Line

6			

COMPLETED

Location _____
 Rig up _____
 Drilling and Remarks:
Chas. 3860
Viola 4121
2000 acid
Potential
6129 oil trace
water

RECORD
 Cased _____ in., _____ ft.
 Sand _____
 Gas _____
 Oil _____
 Total Depth 4127
PRODUCTION
 1st 24 hrs. Nat. _____
 1st 24 hrs. after shot _____
 Gas _____ Cu. Ft.
 Dry Hole _____
 Abandoned _____

Date FEB 3 1937 19 S. J. LEWIS Scout

Form 26—1M Bks.—2-29 **KANSAS**
 Map No. 41 Sec. 14 Twp. 26 R. 9W
 Well No. 3 Whipple
Shell Company
 Contractor

SECTION PLAT

440 Ft. from N. Line
 _____ Ft. from S. Line
 _____ Ft. from E. Line
1299 Ft. from W. Line

6			

FIRST REPORT

Location _____
 Rig up _____
 Drilling and Remarks:
Rigging up

RECORD
 Cased _____ in., _____ ft.
 Sand _____
 Gas _____
 Oil _____
 Total Depth _____
PRODUCTION
 1st 24 hrs. Nat. _____
 1st 24 hrs. after shot _____
 Gas _____ Cu. Ft.
 Dry Hole _____
 Abandoned _____

Date DEC 22 1936 19 S. J. LEWIS Scout