


Section 15 Township 26 Range 9-W

Well Number #1 Lawson

Company Ohio Oil

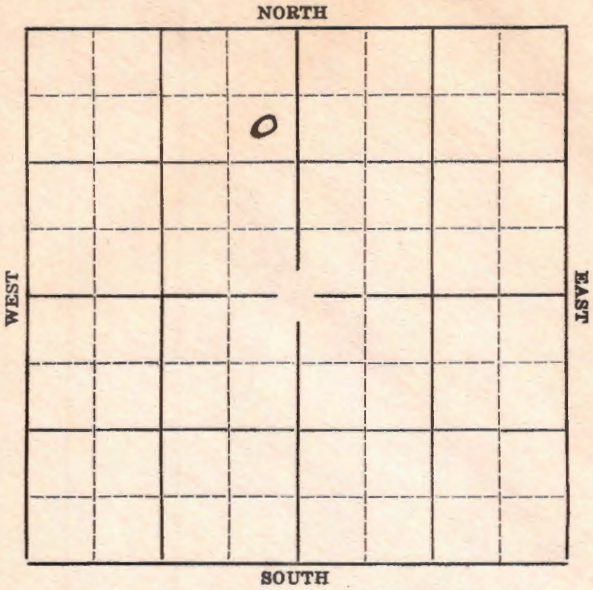

Sec. 15 Twp. 26 R. 9W

Well No. #1 Lawson Farm

Ohio Oil Company


990' Ft. from N. Line

\_\_\_\_\_ Ft. from S. Line

330' Ft. from E. Line

\_\_\_\_\_ Ft. from W. Line

**Elev. 1686**

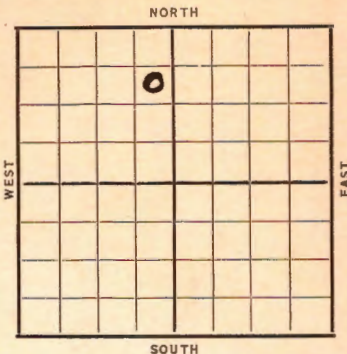

1936	REPORT
10/28	Rig.
11/6	Rigging up
11/12	12" @ 333 WOC
11/19	Drlg. 2875'.
11/27	Chat 3880'. Drlg. 3940'.
12/3	Viola 4147'. T. D. 4149'.
	Rust.
12/10	Flow Potential 2473. 44 gravity
	oil. 2000 acid. No test.
12/16	Viola 4147'. 2000 acid.
	T. D. 4149½'.
	Pot. 6409.
	<b>COMPLETED</b>

Map No. 41 Sec. 15 Twp. 26 R. 9W

Well No. 1 Lawson

Ohio Oil Company

Contractor

SECTION PLAT


990 Ft. from N. Line

\_\_\_\_\_ Ft. from S. Line

830 Ft. from E. Line

\_\_\_\_\_ Ft. from W. Line

FIRST REPORT

Location \_\_\_\_\_

Rig up \_\_\_\_\_

Drilling and Remarks:

*Rig*

RECORD

Cased \_\_\_\_\_ in., \_\_\_\_\_ ft.

Sand \_\_\_\_\_

Gas \_\_\_\_\_

Oil \_\_\_\_\_

Total Depth \_\_\_\_\_

PRODUCTION

1st 24 hrs. Nat. \_\_\_\_\_

1st 24 hrs. after shot \_\_\_\_\_

Gas \_\_\_\_\_ Cu. Ft.

Dry Hole \_\_\_\_\_

Abandoned \_\_\_\_\_

Date

OCT 28 1930 19

S. J. LEWIS Scout

**KANSAS**

Map No. 41 Sec. 15 Twp. 26 R. 94

Well No. Lawson

Ohio Oil Company

Contractor

**SECTION PLAT**

	o		

990 Ft. from N. Line

\_\_\_\_\_ Ft. from S. Line

330 Ft. from E. Line

\_\_\_\_\_ Ft. from W. Line

**COMPLETED**

Location \_\_\_\_\_

Rig up \_\_\_\_\_

Drilling and Remarks:

*Vedla 4147*  
*2000 acid*  
*Log 6409*

**RECORD**

Cased \_\_\_\_\_ in., \_\_\_\_\_ ft.

Sand \_\_\_\_\_

Gas \_\_\_\_\_

Oil \_\_\_\_\_

Total Depth 4149 1/2

**PRODUCTION**

1st 24 hrs. Nat. \_\_\_\_\_

1st 24 hrs. after shot \_\_\_\_\_

Gas \_\_\_\_\_ Cu. Ft.

Dry Hole \_\_\_\_\_

Abandoned \_\_\_\_\_

Date

DEC 16 1936

19

S. J. LEWIS Scout