
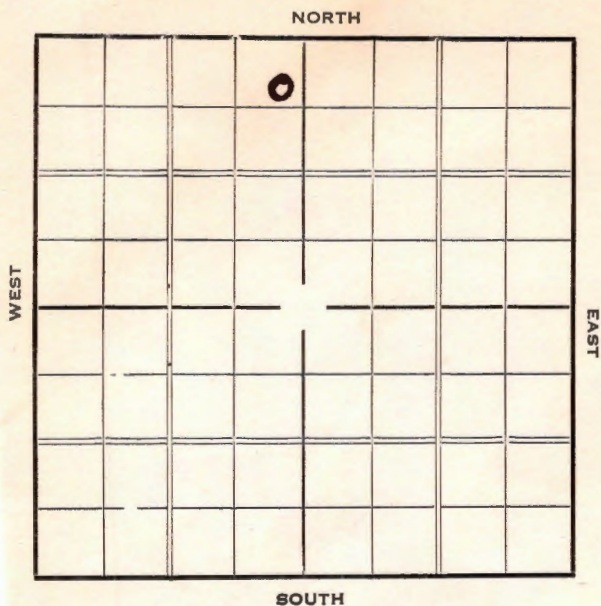


Section 15 Township 26 Range 9-WWell Number 1 - Salt water Disposal
Lawson LseCompany Ohio

Sec. 15 Twp. 26 R. 9-WWell No. #1 Salt Water Disposal Farm
(Lawson lse)
Ohio Company530 Ft. from N. Line Ft. from S. Line240 Ft. from E. Line Ft. from W. Line

NORTH

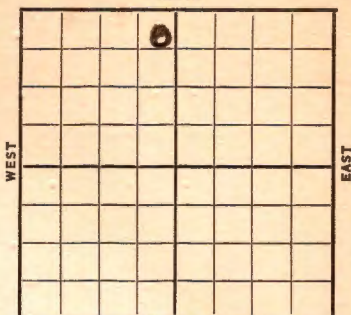

SOUTH

Elev. 1686

Date	REPORT
1937	
5/5	12" @ 106'.
	10" @ 417'.
	T.D. 850'. SD repairs.
5/14	SD 1325'.
5/21	Drlg. 1803'.
5/28	" "
6/4	T.D. 2165'. Rng. 6".
6/11	T.D. 2325'. 6" @ 2056'.
6/19	6" @ 2165'. Drlg. 2535'.
6/25	T.D. 2797'. Testing.
7/2	T.D. 2797' S DO
7/9	T.D. 3800'. Testi.jg.
7/16	T.D. 2800'. 6" @ 2781'.
7/23	T.D. 2842'. Testing.
7/30	T.D. 2952'. Testing intake.
8/6	S. O. & G. 2971-75'. T.D. 2977'.
	S.D.O.
8/13	"
8/20	"
8/28	"

OVER

1937

9/3 6" @ 2971'. Drlg. 3005'.

9/10 K.C. 3350'. U.R. 6".
No shows rep.

9/17 U. R. 6".

9/24 6" @ 3351'. S.O. 3397-3400'.
S.G. 3400-05'. 2 B.W. 3475-85'.
Drlg. 3500'.

10/2 T.D. 3531' S.O. 6" @ 3508'.

10/8 S.O. 3605-09'. T.D. 3825'.
U.R. 6".

10/15 Chat 3876'. S.G. 3900-04'.
T.D. 3915'. Rng. 5".

10/22 S.S.O. 3948-52'. 5" @ 3913'.
T.D. 3957'. Fishg.

10/29 Chat 3889'. Viola 4150 & 7".
T.D. 4153'. Stain oil 4151-53'.

11/5 " " " " "

11/12 T.D. 3957'. $\frac{3}{4}$ M gas.
Acidizing.

11/19 " " "

11/26 2500 acid.

12/3 " "

12/10 " "

OVER

1937

12/15 5" @ 3913'.

Miss. 3925'.

T.D. 3957'.

Was started for a salt water
disposal well but completed for
1/2 M gas.

2500 acid.

COMPLETED

Reno

KANSAS

Map No. 41 Sec. 15 Twp. 26 R. 9WWell No. 1 -Salt Water Disposal (Lawson)

Ohio

Company

Contractor

COMPLETED

NE NW

530 Ft. from N. Line

Ft. from S. Line

240 Ft. from E. Line

Ft. from W. Line

SECTION PLAT

		0	

Location

Rig up

Drilling and Remarks:

was started for a salt
water disp. well but
completed for

$\frac{1}{2}$ M gas

2500 Acid

RECORD

Cased 5 in., 3913 ft.Sand MISS 3925

Gas

Oil

Total Depth 3957

PRODUCTION

1st 24 hrs. Nat.

1st 24 hrs. after shot

Gas Cu. Ft.

Dry Hole

Abandoned

Date

DEC 15 1937

19

H. D. Hatfield

Scout

Map No. 41 Sec. 15 Twp. 26 R. 9WWell No. 1 - Salt Water Disposal
Ohio (Lawson Lee) Company

Contractor

FIRST REPORT

SECTION PLAT

530 Ft. from N. Line

_____ Ft. from S. Line

240 Ft. from E. Line

_____ Ft. from W. Line

	0		

Location _____

RECORD

Cased _____ in., _____ ft.

Sand _____

Gas _____

Oil _____

Total Depth _____

PRODUCTION

1st 24 hrs. Nat. _____

1st 24 hrs. after shot _____

Gas _____ Cu. Ft.

Dry Hole _____

Abandoned _____

Rig up _____

Drilling and Remarks:

12" - 10610" - 417T.O. 850 S.D. Repairs

Date

MAY 5 - 1907

19

H. D. Hatfield Scout