


Reno

KANSAS

Section 15 Township 26 Range 9-W

Well Number 2 Lawson

Company Ohio Oil

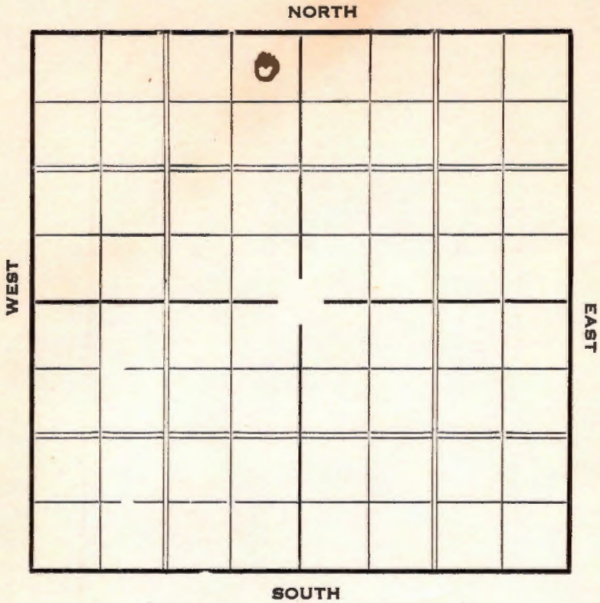

Map No. \_\_\_\_\_ Sec. 15 Twp. 26 R. 9-W

Well No. #2 Lawson Farm \_\_\_\_\_

Ohio Oil Company \_\_\_\_\_


330 Ft. from N. Line

\_\_\_\_\_ Ft. from S. Line

330 Ft. from E. Line

\_\_\_\_\_ Ft. from W. Line

**Elev. 1686**

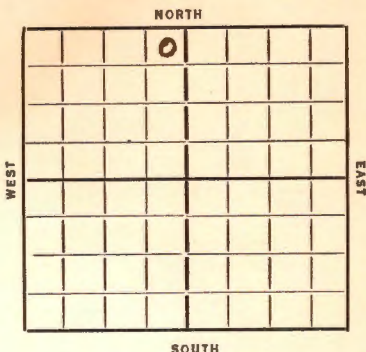

Date  
1936

REPORT

12/22 Rig

12/29 Spud.

1937

1/7 15" @ 336'. Drlg. 2610'.

1/14 Drlg. 3865'.

1/21 **Viola 4147'** set 7". RUST.

1/28 T. D. 4154'. 3000 acid.

No test.

2/3 **Viola 4147'**.

T. D. 4154'.

3000 acid.

Potential 7176 bbls.

**COMPLETED**

Map No. 41 Sec. 15 Twp. 26 R. 9W

Well No. 2 Lawson

Ohio Oil Company

Contractor

SECTION PLAT

	0		

330 Ft. from N. Line

\_\_\_\_\_ Ft. from S. Line

380 Ft. from E. Line

\_\_\_\_\_ Ft. from W. Line

COMPLETED

Location \_\_\_\_\_

Rig up \_\_\_\_\_

Drilling and Remarks:

*Viola 4147*  
*3000 acid*  
*Potential*  
*7176 fls.*

RECORD

Cased \_\_\_\_\_ in., \_\_\_\_\_ ft.

Sand \_\_\_\_\_

Gas \_\_\_\_\_

Oil \_\_\_\_\_

Total Depth 4154

PRODUCTION

1st 24 hrs. Nat. \_\_\_\_\_

1st 24 hrs. after shot \_\_\_\_\_

Gas \_\_\_\_\_ Cu. Ft.

Dry Hole \_\_\_\_\_

Abandoned \_\_\_\_\_

Date

FEB 3 1937

19

S. J. LEWIS Scout

**KANSAS**

Map No. 41 Sec. 15 Twp. 26 R. 9W.

Well No. 2 Lawson.

Ohio Oil

Company

Contractor

**SECTION PLAT**

	0		

330 Ft. from N. Line

\_\_\_\_\_ Ft. from S. Line

330 Ft. from E. Line

\_\_\_\_\_ Ft. from W. Line

**FIRST REPORT**

Location \_\_\_\_\_

Rig up \_\_\_\_\_

Drilling and Remarks:

*Rig*

**RECORD**

Cased \_\_\_\_\_ in., \_\_\_\_\_ ft.

Sand \_\_\_\_\_

Gas \_\_\_\_\_

Oil \_\_\_\_\_

Total Depth \_\_\_\_\_

**PRODUCTION**

1st 24 hrs. Nat. \_\_\_\_\_

1st 24 hrs. after shot \_\_\_\_\_

Gas \_\_\_\_\_ Cu. Ft.

Dry Hole \_\_\_\_\_

Abandoned \_\_\_\_\_

Date

DEC 22 1936 <sub>19</sub>

S. J. LEWIS Scout