


Section 15 Township 26 Range 9-W

Well Number 4 Lawson

Company Ohio Oil

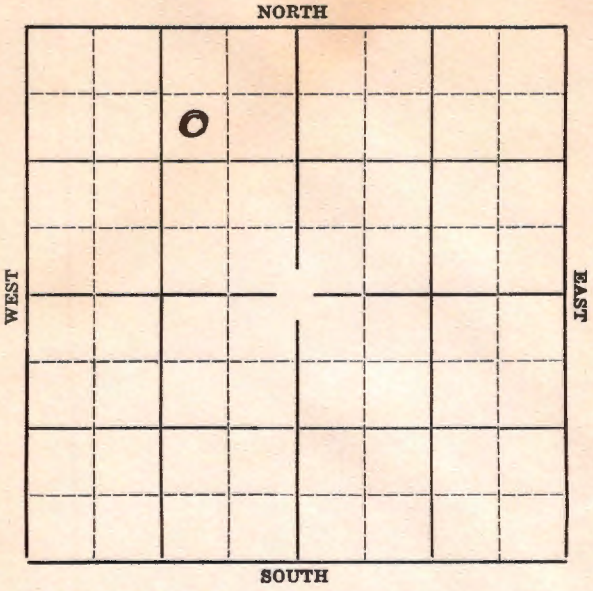

Sec. 15 Twp. 26 R. 9-W

Well No. #4 Lawson Farm  
Ohio Oil Company


990 Ft. from N. Line

           Ft. from S. Line

990 Ft. from E. Line

           Ft. from W. Line

**Elev. 1691**

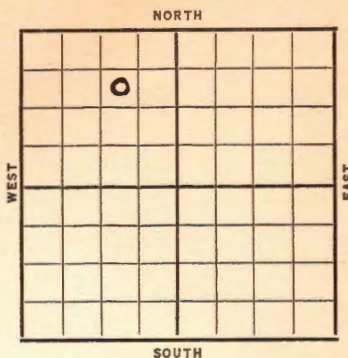

Date	REPORT
1937	
3/17	Location
3/25	"
4/2	Rig.
4/8	"
4/16	15" @ 349'. Drlg. 2125'.
4/23	Drlg. 39 40'.
4/30	<b>Viola 4149'.</b> 7" @ 4149'.
	Rng. tubing to acidize.
5/5	<b>Viola 4149'.</b>
	T.D. 4150'.
	1000 A
	Pot. 1433.
	<b>COMPLETED</b>

*Reno* **KANSAS**

Map No. 41 Sec. 15 Twp. 26 R. 9 W

Well No. 4-Lawson

Ohio Company

Contractor

**COMPLETED**

**SECTION PLAT**

990 Ft. from N. Line

\_\_\_\_\_ Ft. from S. Line

990 Ft. from E. Line

\_\_\_\_\_ Ft. from W. Line

	0		

Location \_\_\_\_\_

Rig up \_\_\_\_\_

Drilling and Remarks:

*1000 A*

*P.O.T. - 1433*

**RECORD**

Cased \_\_\_\_\_ in., \_\_\_\_\_ ft.

Sand *Viola* 4149

Gas \_\_\_\_\_

Oil \_\_\_\_\_

Total Depth 4150

**PRODUCTION**

1st 24 hrs. Nat. \_\_\_\_\_

1st 24 hrs. after shot. \_\_\_\_\_

Gas \_\_\_\_\_ Cu. Ft.

Dry Hole \_\_\_\_\_

Abandoned \_\_\_\_\_

Date

**MAY 5 - 1937**

19

*H. Hatfield* Scout

Map No. 41 Sec. 15 Twp. 26 R. 9W.

Well No. 4 Lawson

Ohio Oil Company

Contractor

**SECTION PLAT**

	0		

990 Ft. from N. Line

\_\_\_\_\_ Ft. from S. Line

990 Ft. from E. Line

\_\_\_\_\_ Ft. from W. Line

FIRST REPORT

Location ✓

Rig up \_\_\_\_\_

Drilling and Remarks:

**RECORD**

Cased \_\_\_\_\_ in., \_\_\_\_\_ ft.

Sand \_\_\_\_\_

Gas \_\_\_\_\_

Oil \_\_\_\_\_

Total Depth \_\_\_\_\_

**PRODUCTION**

1st 24 hrs. Nat. \_\_\_\_\_

1st 24 hrs. after shot \_\_\_\_\_

Gas \_\_\_\_\_ Cu. Ft.

Dry Hole \_\_\_\_\_

Abandoned \_\_\_\_\_

Date

MAR 17 1937 19

S. J. LEWIS Scout