


Section 15 Township 26 Range 9-W

Well Number 3 Lawson

Company Ohio Oil

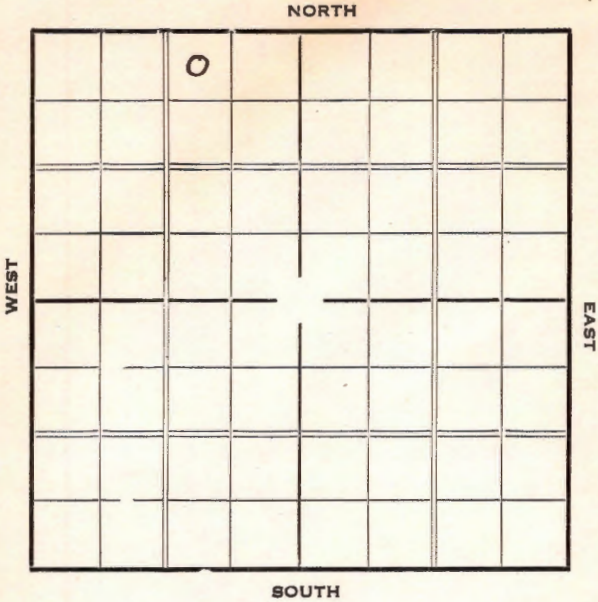

Sec. 15 Twp. 26 R. 9-W

Well No. #3 Lawson Farm

Ohio Oil Company


330 Ft. from N. Line

\_\_\_\_\_ Ft. from S. Line

990 Ft. from E. Line

\_\_\_\_\_ Ft. from W. Line

*Elev. 1691*

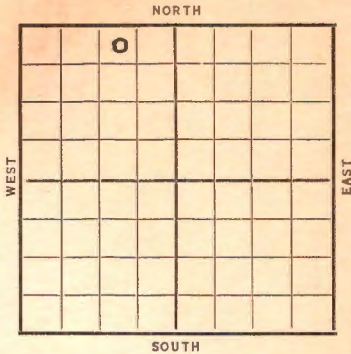

| Date | REPORT                       |
|------|------------------------------|
| 1937 |                              |
| 2/10 | Location                     |
| 2/18 | Rigging up                   |
| 2/26 | 15" @ 344' Drlg. 1678'.      |
| 3/4  | Drlg. 3407'.                 |
| 3/11 | Viola 4152' Set 7" RUST      |
| 3/18 | TD 4159' - 2000 oil in hole. |
|      |                              |
|      |                              |
| 3/24 | Viola 4152'.                 |
|      | T. D. 4159'.                 |
|      | 4000 acid.                   |
|      | Potential 936.               |
|      | <b>COMPLETED</b>             |
|      |                              |
|      |                              |
Map No. 41 Sec. 15 Twp. 26 R. 9W.

Well No. 3 Lawson.

Ohio Company

Contractor

**SECTION PLAT**

|  |   |  |  |
|--|---|--|--|
|  | 0 |  |  |
|  |   |  |  |
|  |   |  |  |
|  |   |  |  |

330 Ft. from N. Line

\_\_\_\_\_ Ft. from S. Line

990 Ft. from E. Line

\_\_\_\_\_ Ft. from W. Line

**COMPLETED**

Location \_\_\_\_\_

Rig up \_\_\_\_\_

Drilling and Remarks:

*Viola 4152*

*4000 acid*

*Potential*

*936*

**RECORD**

Cased \_\_\_\_\_ in., \_\_\_\_\_ ft.

Sand \_\_\_\_\_

Gas \_\_\_\_\_

Oil \_\_\_\_\_

Total Depth 4159

**PRODUCTION**

1st 24 hrs. Nat. \_\_\_\_\_

1st 24 hrs. after shot \_\_\_\_\_

Gas \_\_\_\_\_ Cu. Ft.

Dry Hole \_\_\_\_\_

Abandoned \_\_\_\_\_

Date

MAR 24 1937 19

S. J. LEWIS Scout

Map No. 41 Sec. 15 Twp. 26 R. 9W

Well No. 3 Lawson

Ohio Oil Company

Contractor

**SECTION PLAT**

|  |   |  |  |
|--|---|--|--|
|  | 0 |  |  |
|  |   |  |  |
|  |   |  |  |
|  |   |  |  |

330 Ft. from N. Line

\_\_\_\_\_ Ft. from S. Line

990 Ft. from E. Line

\_\_\_\_\_ Ft. from W. Line

**FIRST REPORT**

Location ✓

Rig up \_\_\_\_\_

Drilling and Remarks:

**RECORD**

Cased \_\_\_\_\_ in., \_\_\_\_\_ ft.

Sand \_\_\_\_\_

Gas \_\_\_\_\_

Oil \_\_\_\_\_

Total Depth \_\_\_\_\_

**PRODUCTION**

1st 24 hrs. Nat. \_\_\_\_\_

1st 24 hrs. after shot \_\_\_\_\_

Gas \_\_\_\_\_ Cu. Ft.

Dry Hole \_\_\_\_\_

Abandoned \_\_\_\_\_

Date

FEB 10 1937

19

S. J. LEWIS Scout