

OWWO

Reno

KANSAS

15

26S

9W

SECTION _____ TOWNSHIP _____ RANGE _____


WELL NO. #1 Lawson-JonesCOMPANY Messman-Rinehart

NORTH

SW NE ~~SW~~ NW

WEST

EAST

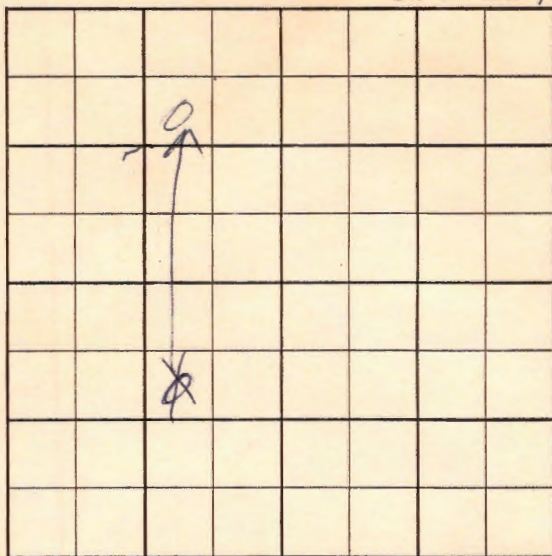

SOUTH

O.W.W.O.

27

FORM 513 SUNRAY

County ~~Refo~~ Elev. 1691
Sec. 15 Twp. 26 Rge. 9W
Company ~~Messman-Rinehart~~
Farm Name ~~Lawson-Jones~~ No. 1

TOPS	DEPTH	LOG	DATUM	Loc. in Sec.
Anh.				SW NE SW
Tp.				OWWO
H.				
Tr.				
Dg.				
BL.				
L.				Geol.
K.C.				Contr.
B.K.C.				
Ce.				Co. tools
C.				
M.				Pool
M.				
K.				Lorado
Mz.				
Mo.				
V.	4148			
S.				
S.				
A.				
R.				
Pe.				
G.				
T.B.				

FIRST REPORT
SEP 18 1917

Date Comm. OTD 4150 M I R

NO-RECORD

Co.
Lse.
No.
Sec.
T.
R.

O.W.W.O.

FORM 513 SUNRAY

County Reno Elev. 1691
 Sec. 15 Twp. 26 Rge. 9W
 Company Messman-Rinehart
 Farm Name Lawson-Jones No. 1

TOPS	DEPTH	LOG	DATUM	Loc. in Sec.
Anh.				SW NW <u>NW</u>
TP.				<u>DWNO</u>
H.				
Tr.				
Dg.				
BL.				
L.				Geol.
K.C.				Contr.
B.K.C.				Co. tools
Ce.				Pool
C.				Lorado
M.				ABANDONED SEP 25 '57
M.				
K.				
Mz.				
Me.				
V.	1118			
S.				
A.				
R.				
Pe.				
G.				
T.D.				

Date Comm. OTD 4150 M I R SEP 20 '57 lost hole
2060

D & A