


O.W.W.O.

Section 15 Township 26 Range 9-W

Well Number ~~3 Mauch~~ # 2 Lawson Jones

Company ~~Empire~~ Messmer-Rinehart

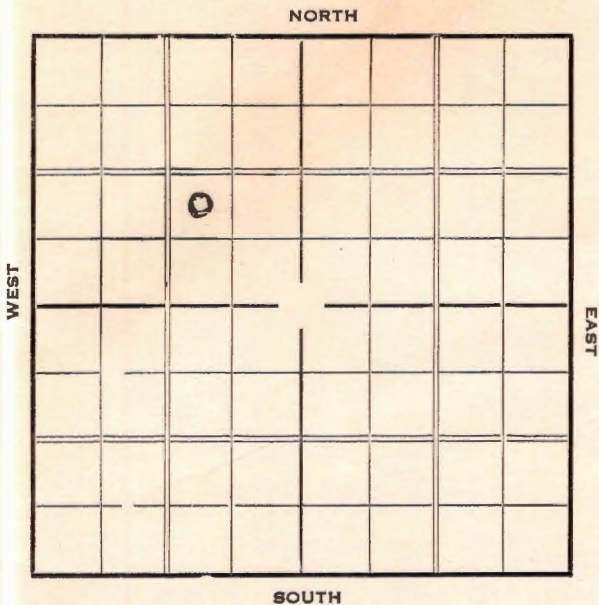

Sec. 15 Twp. 26 R. 9-W

Well No. #3 Mauch Farm \_\_\_\_\_  
Empire Company \_\_\_\_\_


\_\_\_\_\_ Ft. from N. Line

990 Ft. from S. Line

990 Ft. from E. Line

\_\_\_\_\_ Ft. from W. Line

**Elev. 1691**

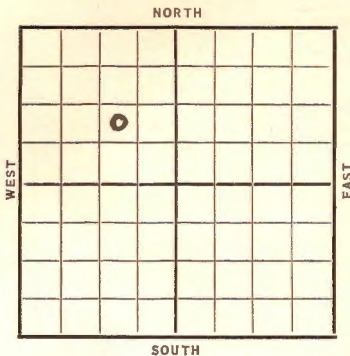

Date	REPORT
1937 3/3	12" @ 307'. WOC.
3/11	Drlg. 1759'
3/18	Lensing 3347' Drlg. 3615'
3/25	Coring 4152'.
4/2	Viola 4148'. 7" @ 4149' WOC
4/8	TD 4156½, 4000 acid Potential 3340'
4/14	Viola 4148'.
	T.D. 4156½'.
	4000 acid.
	Potential 3340.
	<b>COMPLETED</b>



Map No. 41 Sec. 15 Twp. 26 R. 9W

Well No. 3 Mauch

Empire Company

Contractor

**SECTION PLAT**

	o		

\_\_\_\_\_ Ft. from N. Line

990 Ft. from S. Line

990 Ft. from E. Line

\_\_\_\_\_ Ft. from W. Line

**COMPLETED**

**RECORD**

Location \_\_\_\_\_

Cased \_\_\_\_\_ in., \_\_\_\_\_ ft.

Rig up \_\_\_\_\_

Sand \_\_\_\_\_

Drilling and Remarks:

Gas \_\_\_\_\_

*Viola 4148.*

Oil \_\_\_\_\_

*4000 acid*

Total Depth 4156 1/2

*Potential*

**PRODUCTION**

*3340*

1st 24 hrs. Nat. \_\_\_\_\_

1st 24 hrs. after shot \_\_\_\_\_

Gas \_\_\_\_\_ Cu. Ft.

Dry Hole \_\_\_\_\_

Abandoned \_\_\_\_\_

Date

APR 14 1937 19

S. J. LEWIS Scout



O.W.W.O.

5-513-A

CO. Reno ELEV. 1691 DF .

SEC. 15 TWP. 26 RGE. 9W

COMPANY Messman-Rinehart 2  
(was Empire #3 Mavck)

COMPLETE

OCT 16 '57

FARM Lawson Jones

LOC. NW SE NW (CWWO)

Lans.	3347
Viola	4148
M 3897	

GEOL. \_\_\_\_\_

CONTR. Co. tools

POOL Lorado

SPUD \_\_\_\_\_

OTD 4156 MIR OCT 2 '57

C04019 #1019

W/OCT OCT 9 '57

20/3894-99 1/2

ga .500 mcf frac

2.5 x 5.5 2.00

mcf SI gna well  
Log top, m 3892 m to 3957

CO.

LOC.

NO.

SEC.

TWP.

RGE.