


Section 15 Township 26 Range 9-W

Well Number #1-Mauck

Company Empire

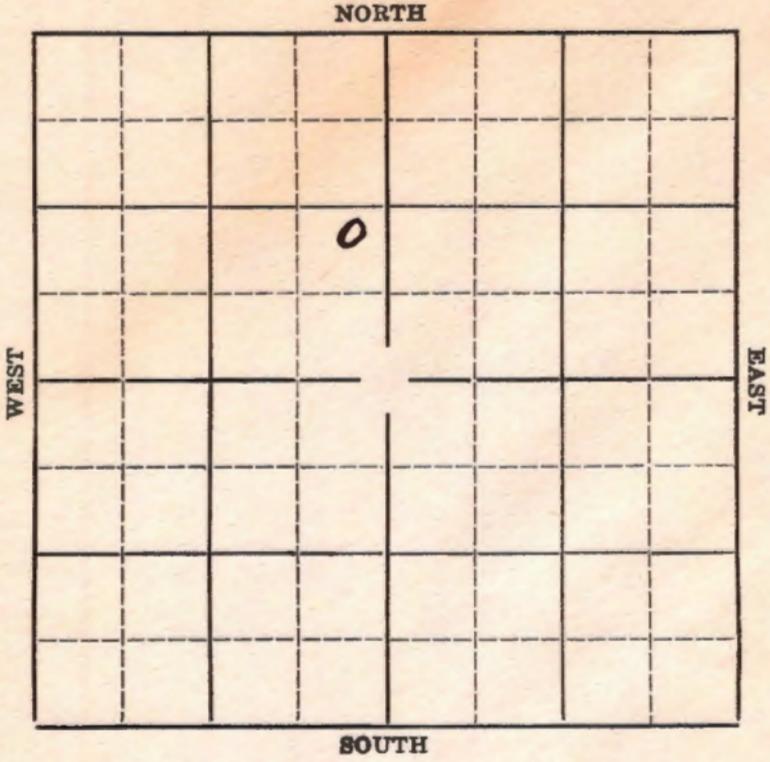

Reno

Map No. **KANSAS** Sec. **15** Twp. **26** R. **9W**


Well No. **#1 Mauck** Farm _____
Empire Company

_____ Ft. from N. Line

1010' Ft. from S. Line

330' Ft. from E. Line

_____ Ft. from W. Line

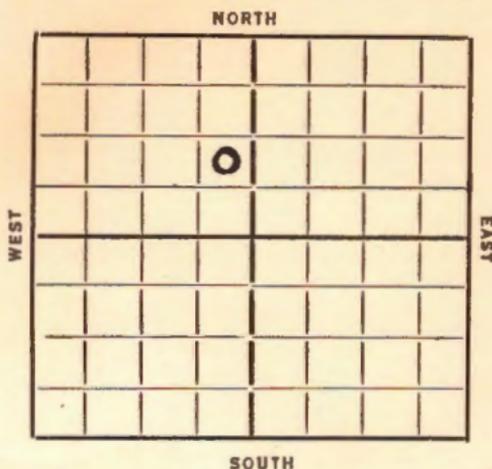

1936

REPORT

8/5 Location

8/13 Rig.

8/20 10" @ 252'. Waiting on cement.

8/27 Drlg. 975'.

9/3 Drlg. 1847'.

9/10 T.D. 4137'. S.D.

9/18 **Shot 3885'**. Drlg. 3890'.

9/24 **Mississippi L. 4144'**. S.D.

10/1 -- **10/8** -- ~~to/x~~

10/15 T.D. 4151½'. testing.

10/22 -4000 gallons of acid. Flow 1537 bbls in 6 hours.

10/28/36 - **Viola 4143'**.

T.D. 4151½'

Flow 6708 bbls .

COMPLETED.

Map No. 41 Sec. 15 Twp. 26 R. 9W

Well No. L. March

Empire Company

Contractor

SECTION PLAT

		0	

_____ Ft. from N. Line

1010 Ft. from S. Line

230 Ft. from E. Line

_____ Ft. from W. Line

COMPLETED

Location _____

Rig up _____

Drilling and Remarks:

Viola 4143

Flow 6708

RECORD

Cased _____ in., _____ ft.

Sand _____

Gas _____

Oil _____

Total Depth 415 1/2

PRODUCTION

1st 24 hrs. Nat. _____

1st 24 hrs. after shot _____

Gas _____ Cu. Ft.

Dry Hole _____

Abandoned _____

Date

OCT 28 1936

S. J. LEWIS

Scout

Map No. 41 Sec. 15 Twp. 26 R. 9W

Well No. 1 Mauch

Empire Company

Contractor

SECTION PLAT

		o	

_____ Ft. from N. Line

1010 Ft. from S. Line

320 Ft. from E. Line

_____ Ft. from W. Line

FIRST REPORT

Location ✓

Rig up _____

Drilling and Remarks:

RECORD

Cased _____ in., _____ ft.

Sand _____

Gas _____

Oil _____

Total Depth _____

PRODUCTION

1st 24 hrs. Nat. _____

1st 24 hrs. after shot _____

Gas _____ Cu. Ft.

Dry Hole _____

Abandoned _____

Date

AUG 5 1936 19

S. J. LEWIS Scout