


Section 15 Township 26 Range 9-W

Well Number #2 Mauck (*Mauck*)

Company Empire

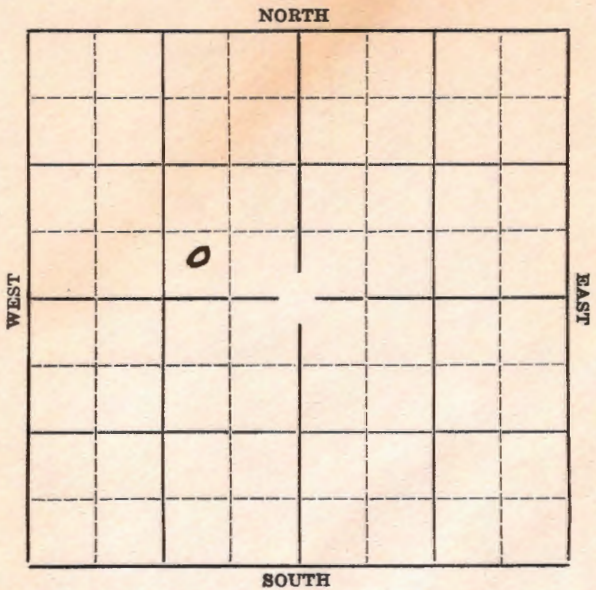

Sec. 15 Twp. 26 R. 9W

Well No. #2 Mauch Farm _____
Empire Company _____


_____ Ft. from N. Line

330' Ft. from S. Line

990' Ft. from E. Line

_____ Ft. from W. Line

Elev. 1690

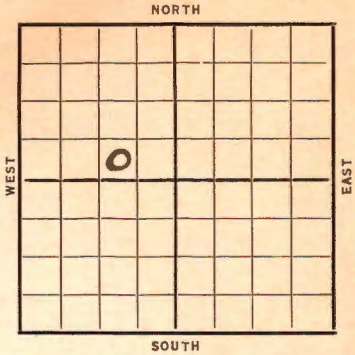

Date	REPORT
1936 10/21	Location.
10/29	Rig on ground.
11/6	12" @ 306 Drlg. 650
11/12	Drlg. 2687
11/19	Drlg. 3882'.
11/27	Chat 3890'. Viola 4156'. T. D. 4158'. Fishing.
12/3	Rust.
12/10	T. D. 4161½'. 2000 acid. No test.
12/16	Viola 4151'. 2000 acid. T. D. 4161½'. Pot. 5980'. 6% water.
COMPLETED	

KANSAS

Map No. 41 Sec. 15 Twp. 26 R. 9W.

Well No. 2 Mauck

Empire

Company

Contractor

SECTION PLAT

	o		

_____ Ft. from N. Line

880 Ft. from S. Line

990 Ft. from E. Line

_____ Ft. from W. Line

COMPLETED

Location _____

Rig up _____

Drilling and Remarks:

Virla 4151
2000 acid
P 85980
6% water

RECORD

Cased _____ in., _____ ft.

Sand _____

Gas _____

Oil _____

Total Depth 416 1/2

PRODUCTION

1st 24 hrs. Nat. _____

1st 24 hrs. after shot _____

Gas _____ Cu. Ft.

Dry Hole _____

Abandoned _____

Date

DEC 16 1936 19

S. J. LEWIS Scout

Map No. 41 Sec. 15 Twp. 26 R. 9W

Well No. 2 Hauck

Empire Company

Contractor

SECTION PLAT

	0		

 Ft. from N. Line

330 Ft. from S. Line

990 Ft. from E. Line

 Ft. from W. Line

FIRST REPORT

Location ✓

Rig up

Drilling and Remarks:

RECORD

Cased in., ft.

Sand

Gas

Oil

Total Depth

PRODUCTION

1st 24 hrs. Nat.

1st 24 hrs. after shot

Gas Cu. Ft.

Dry Hole

Abandoned

Date

OCT 21 1936 19

S. J. LEWIS Scout