


Section.....15.....Township.....26.....Range.....9-W.....

Well Number.....5 Mauch.....

Company.....Empire.....

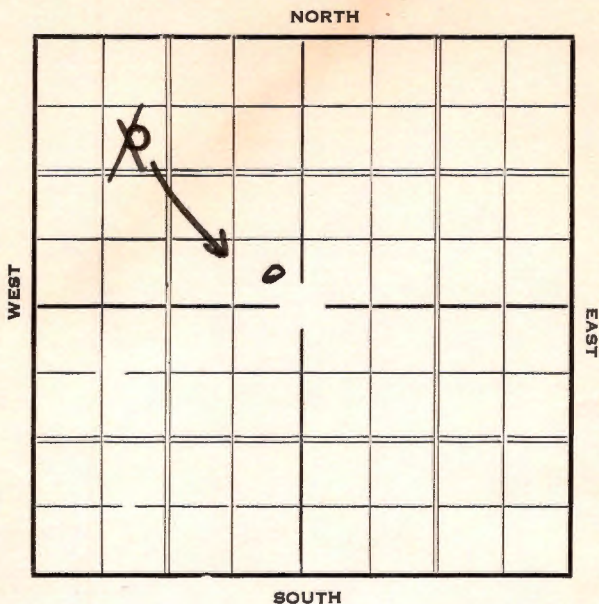

Sec. 15 Twp. 26 R. 9-W

Well No. #5 Mauch Farm


Empire Company

~~330~~ Ft. from N. Line

330 Ft. from S. Line

330 Ft. from E. Line

~~330~~ Ft. from W. Line

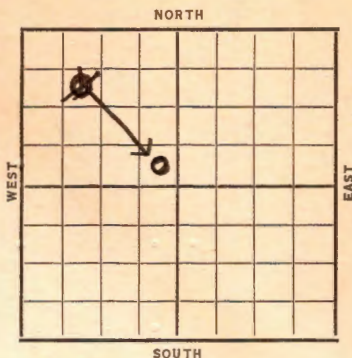

Date	REPORT
1937	
4/21	Location
4/30	"
5/7	"
5/14	"
5/21	"
5/28	"
6/4	"
6/11	Drlg. 325'.
6/19	12" @ 308'. Drlg. 2195'.
6/25	K.C. 3415'. Drlg. 3650'.
7/2	Topeka 2820'.
	K.C. 3360' (Corrected)
	Viola 4145'. 7" @ 4143'.
7/9	Viola 4141'. T.D. 4143'.
	(Corrected) H.F.O. 24 hrs.

OVER

1937

7/14

7" @ 4141'.

Viola 4141' (Corrected) 0

T.D. 4143'.

Flowed 577 bbls. 6 hrs.

Pot. 2186 bbls.

COMPLETED

Reno **KANSAS**

Map No. 41 Sec. 15 Twp. 26 R. 9 W

Well No. 5-Manuck

Empire Company

Contractor

COMPLETED

SECTION PLAT

1430 Ft. from N. Line

330 Ft. from S. Line

330 Ft. from E. Line

_____ Ft. from W. Line

(See Correction Ticket)

Location _____

Rig up _____

Drilling and Remarks:

Flowed

577/6 hrs

POT - 2186

RECORD

Cased 7 in., 4141 ft.

Sand Viola - 4141

Gas (Corrected)

Oil _____

Total Depth 4143

PRODUCTION

1st 24 hrs. Nat. _____

1st 24 hrs. after shot _____

Gas _____ Cu. Ft.

Dry Hole _____

Abandoned _____

Date

JUL 14 1937 19

H. D. Hatfield Scout

KANSAS

Reno

Map No. 41 Sec. 15 Twp. 26 R. 9W

Well No. 5 Mauch

Empire Company

Contractor

SECTION PLAT

0			

990 Ft. from N. Line

_____ Ft. from S. Line

_____ Ft. from E. Line

990 Ft. from W. Line

FIRST REPORT

Location ✓

Rig up _____

Drilling and Remarks:

RECORD

Cased _____ in., _____ ft.

Sand _____

Gas _____

Oil _____

Total Depth _____

PRODUCTION

1st 24 hrs. Nat. _____

1st 24 hrs. after shot _____

Gas _____ Cu. Ft.

Dry Hole _____

Abandoned _____

Date

APR 21 1937 19

S. J. LEWIS Scout

Reno **KANSAS**

Map No. _____ Sec. 15 Twp. 26 R. 9W

Well No. 5-mauch

Empire Company

Contractor

CORRECTION

_____ Ft. from N. Line

330 Ft. from S. Line

330 Ft. from E. Line

_____ Ft. from W. Line

SECTION PLAT

	0		

Location _____

Rig up _____

Drilling and Remarks:

*First Reported as
SE NWNW*

RECORD

Cased _____ in., _____ ft.

Sand _____

Gas _____

Oil _____

Total Depth _____

PRODUCTION

1st 24 hrs. Nat. _____

1st 24 hrs. after shot _____

Gas _____ Cu. Ft.

Dry Hole _____

Abandoned _____

Date

JUL 14 1937 19

H. D. Hatfield Scout