

KANSAS


Form 51-5M-4-36-Palace

Reno

Section 15 Township 26 Range 9W

Well Number #1 M. Whipple

Company Shell

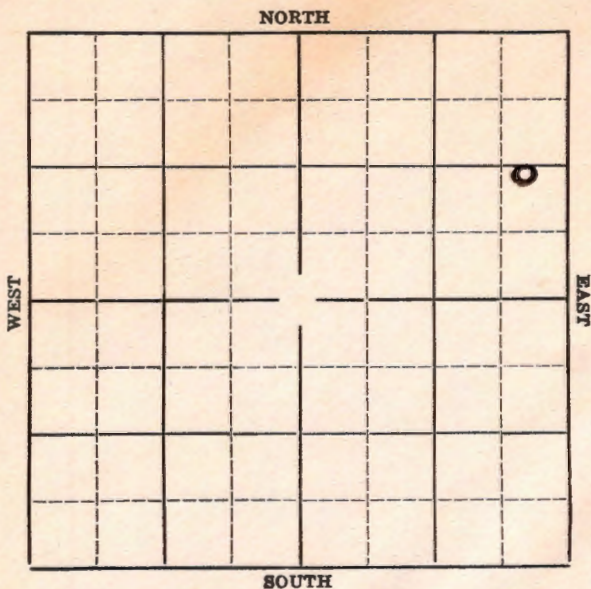

Map No. **KANSAS** Sec. **15** Twp. **26** R. **9W**Well No. **#1 M. Whipple** Farm**Shell**


Company

1327' Ft. from N. Line

Ft. from S. Line

440' Ft. from E. Line

Ft. from W. Line

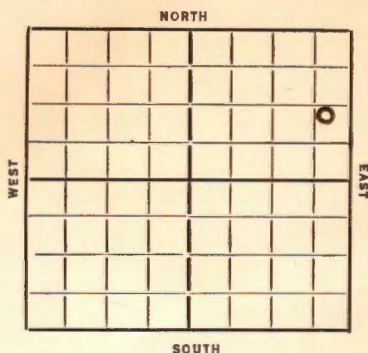Elev. 1670Date
1936

REPORT

5/20 Rigging up.**5/28** Drlg. 1500'.**6/4** Drlg. 3250'.**6/11** Drlg. 3710'.**7/1/36-Viola 4131'.**

1000 gallons of acid.

2000 " " "

T.D. 4147'.

8,000 bbls of oil. (Potential)

COMPLETED

KANSASMap No. 41 Sec. 15 Twp. 26 R. 9 WWell No. 1 M. V. HippieShell Company

Contractor

SECTION PLAT

			9

1327 Ft. from N. Line

_____ Ft. from S. Line

440 Ft. from E. Line

_____ Ft. from W. Line

FIRST REPORT

Location _____

Rig up _____

Drilling and Remarks:

Rigging up**RECORD**

Cased _____ in., _____ ft.

Sand _____

Gas _____

Oil _____

Total Depth _____

PRODUCTION

1st 24 hrs. Nat. _____

1st 24 hrs. after shot _____

Gas _____ Cu. Ft.

Dry Hole _____

Abandoned _____

Date

MAY 20 1936 19

S. J. LEWIS

Scout

KANSAS

Map No. 41 Sec. 15 Twp. 26 R. 9WWell No. 1 M WhippleShell Company

Contractor

SECTION PLAT

1327 Ft. from N. Line

Ft. from S. Line

440 Ft. from E. Line

Ft. from W. Line



COMPLETED

Location _____

Rig up _____

Drilling and Remarks:

Vista 41311000 acid2000 "Pa 85000 8 1/2

RECORD

Cased _____ in., _____ ft.

Sand _____

Gas _____

Oil _____

Total Depth 4147

PRODUCTION

1st 24 hrs. Nat. _____

1st 24 hrs. after shot _____

Gas _____ Cu. Ft.

Dry Hole _____

Abandoned _____

Date

JUL 1 1936

19

S. J. LEWIS Scout