


KANSAS

Reno

Section 15 Township 26 Range 9-W

Well Number 7 M. Whipple

Company Shell

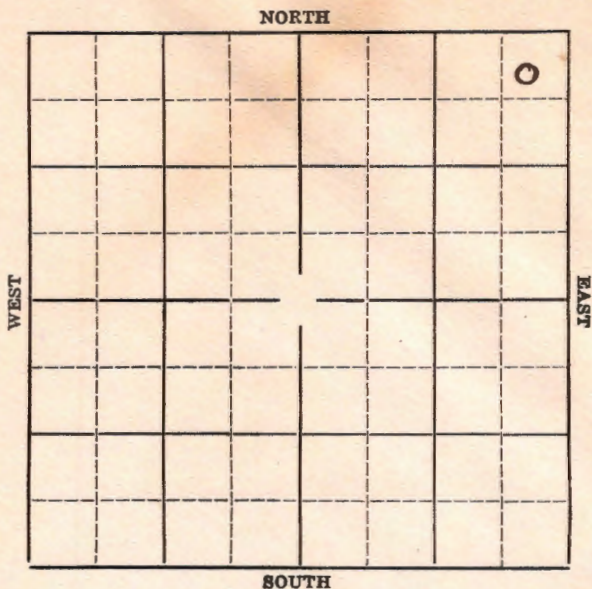

Sec. 15 Twp. 26 R. 9-W

Well No. #7 W. Whipple Farm


Shell _____ Company

440 Ft. from N. Line

Ft. from S. Line

440 Ft. from E. Line

Ft. from W. Line

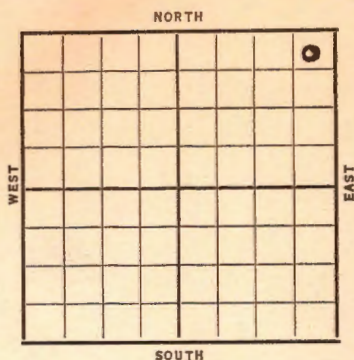[illegible]

KANSAS*Perm.*Map No. 41 Sec. 15 Twp. 26 R. 9W.Well No. 7 M. WhippleShell Company

Contractor

SECTION PLAT

			0

440 Ft. from N. Line

_____ Ft. from S. Line

440 Ft. from E. Line

_____ Ft. from W. Line

FIRST REPORT

Location _____

Rig up _____

Drilling and Remarks:

*Rigging up***RECORD**

Cased _____ in., _____ ft.

Sand _____

Gas _____

Oil _____

Total Depth _____

PRODUCTION

1st 24 hrs. Nat. _____

1st 24 hrs. After shot _____

Gas _____ Cu. Ft.

Dry Hole _____

Abandoned _____

Date

MAR 17 1937 19

S. J. LEWIS

Scout

Reno KANSAS

Map No. _____ Sec. 15 Twp. 26 R. 9 WWell No. 7 - m. Whipple
Shell Company

Contractor _____

SECTION PLAT

			0

COMPLETED440 Ft. from N. Line

_____ Ft. from S. Line

440 Ft. from E. Line

_____ Ft. from W. Line

Location _____

Rig up _____

Drilling and Remarks:

2000 AcidPOT. 3701

RECORD

Cased _____ in., _____ ft.

Sand Viola - 4128

Gas _____

Oil _____

Total Depth 4133

PRODUCTION

1st 24 hrs. Nat. _____

1st 24 hrs. after shot _____

Gas _____ Cu. Ft.

Dry Hole _____

Abandoned _____

Date

APR 28 1937

19

R. D. Hatfield Scout