


Section 15 Township 26 Range 9-W

Well No. 9 - M. Whipple

Company Shell

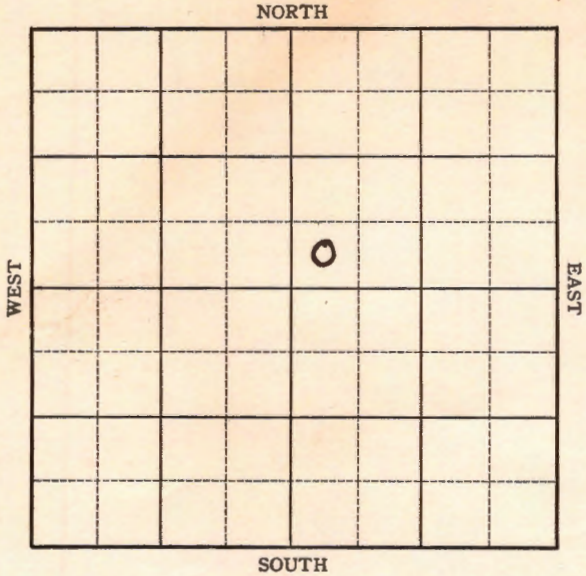

Sec. 15 Twp. 26 R. 9-W

Well No. #9 M. Whipple Farm

Shell Company


 Ft. from N. Line

330 Ft. from S. Line

 Ft. from E. Line

330 Ft. from W. Line

Elev. 1680

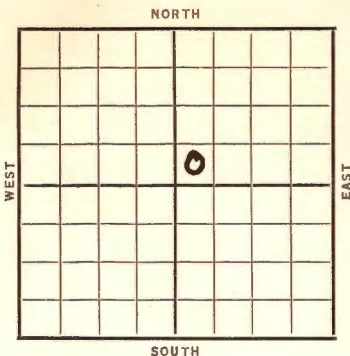

Date

REPORT

1937

5/26

B. R.

6/4

10" @ 347'. Drlg. 1742'.

6/11

Drlg. 3385'.

6/19

Coring 4133'.

6/25

K.C. 3345'. Chat 3882'.

S.O. 4135-40'. Viola 4138'.

7" @ 4138'. T.D. 4140'.

RUST.

6/30

7" @ 4138'.

Viola 4138'.

T.D. 4142'.

2000 A.

Flowed 582 oil 87 water 6 hrs

Potential 2209 bbls.

COMPLETED

Reno **KANSAS**

Map No. _____ Sec. 15 Twp. 26 R. 9 W

Well No. 9-Mary Whipple
Shell Company

Contractor _____

COMPLETED

SECTION PLAT

		0	

_____ Ft. from N. Line

330 Ft. from S. Line

_____ Ft. from E. Line

330 Ft. from W. Line

Location _____

Rig up _____

Drilling and Remarks:

2000 A

*flowed 582 oil
87 water
1
16 hrs*

Pot 2209

RECORD

Cased 7" in., 4138 ft.

Sand Viola 4138

Gas _____

Oil _____

Total Depth 4142

PRODUCTION

1st 24 hrs. Nat. _____

1st 24 hrs. after shot _____

Gas _____ Cu. Ft.

Dry Hole _____

Abandoned _____

Date

H. D. Hatfield

JUN 30 1931

Scout

Reno **KANSAS**

Map No. 41 Sec. 15 Twp. 26 R. 9^w

Well No. 9-M. W. Whipple
Shell Company

Contractor

FIRST REPORT

SECTION PLAT

 Ft. from N. Line

330 Ft. from S. Line

 Ft. from E. Line

330 Ft. from W. Line

		0	

Location

Rig up

Drilling and Remarks:

B.R.

RECORD

Cased in., ft.

Sand

Gas

Oil

Total Depth

PRODUCTION

1st 24 hrs. Nat.

1st 24 hrs. after shot

Gas Cu. Ft.

Dry Hole

Abandoned

Date

MAY 26 1921

H. D. Hatfield Scout