


Section 15 Township 26 Range 9-W

Well Number 8 - Mary Whipple

Company Shell

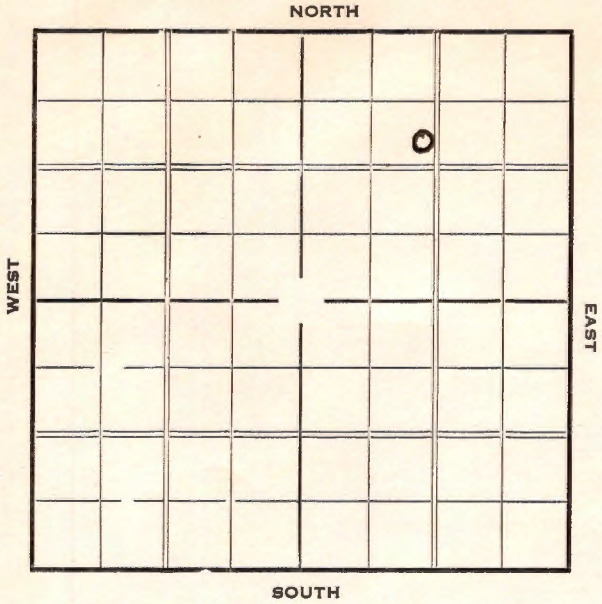

Sec. 15 Twp. 26 R. 9-W

Well No. 8 - Mary Whipple Farm
Shell Company


1120 Ft. from N. Line

_____ Ft. from S. Line

_____ Ft. from E. Line

1220 Ft. from W. Line

Elev. 1678

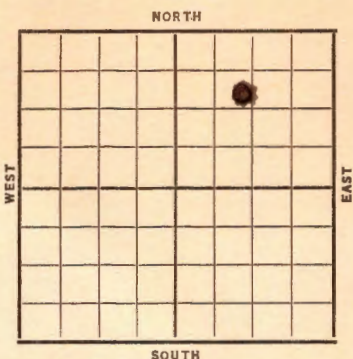

Date	REPORT
1937	
4/28	Mov. in Material
5/7	Drlg. 230'.
5/14	Drlg. 1900'.
5/21	Drlg. 3492'.
5/28	" "
6/4	7" @ 4134'. Viola 4134-39
	T.D. 4139'. 2000 A
6/9	7" @ 4134'.
	Viola 4134'.
	T.D. 4139'.
	2000 acid.
	Flowed 724 bbls. 6 hrs.
	Pot. 2764 bbls.
	COMPLETED

KANSAS

Reno

Map No. 41 Sec. 15 Twp. 26 R. 9^w

Well No. S. M. Whipple

Shell Company

Contractor

COMPLETED

1120 Ft. from N. Line

 Ft. from S. Line

 Ft. from E. Line

1220 Ft. from W. Line

SECTION PLAT

		0	

Location _____

Rig up _____

Drilling and Remarks:

2000 Acid

flowed 724/6/75

Pat - 2764

RECORD

Cased 7 in., 4134 ft.

Sand Viola #134

Gas _____

Oil _____

Total Depth 4139

PRODUCTION

1st 24 hrs. Nat. _____

1st 24 hrs. after shot _____

Gas _____ Cu. Ft.

Dry Hole _____

Abandoned _____

Date

JUN 9 1937

H. D. Hatfield Scout

Reno **KANSAS**

Map No. _____ Sec. 15 Twp. 26 R. 9^W

Well No. 8. Mary Whipple
Shell Company

Contractor _____

FIRST REPORT

SECTION PLAT

		0	

1120 Ft. from N. Line

_____ Ft. from S. Line

_____ Ft. from E. Line

1220 Ft. from W. Line

Location _____

Rig up _____

Drilling and Remarks:

mov. in mat.

RECORD

Cased _____ in., _____ ft.

Sand _____

Gas _____

Oil _____

Total Depth _____

PRODUCTION

1st 24 hrs. Nat. _____

1st 24 hrs. after shot _____

Gas _____ Cu. Ft.

Dry Hole _____

Abandoned _____

Date

APR 28 1937

19

H. Hatfield Scout