


Reno

KANSAS

SECTION 16 TOWNSHIP 26S RANGE 9W

WELL NO. #1 Saylor-Jones Unit

COMPANY Messman-Rinehart

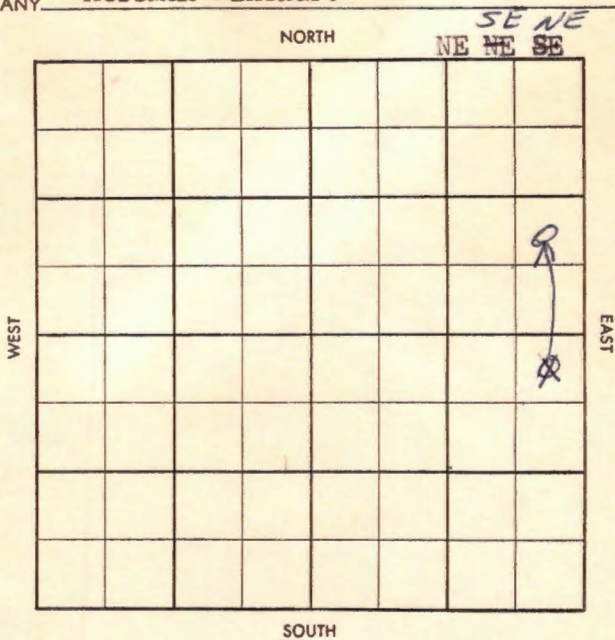

Top ~~X~~ Pool ~~X~~  
 Co. ~~X~~ Facet ~~22~~

S-513-B

County Reno Elev. \_\_\_\_\_  
 Sec. 16 Twp. 26 Rge. 9W  
 Company Messman-Rinehart  
 Farm Name Saylor-Jones Unit No. 1

TOPS	DEPTH	LOG	DATUM
Anh.			
Tp.			
H.			
Tr.			
Dg.			
B.L.			
L.			
K.C.			
B.K.C.			
Ce.			
C.			
M.			
M.			
K.			
Mz.			
Mq.			
V.			
S.			
S.			
A.			
R.			
Pf.			
G.			
T.D.			

Loc. in Sec. \_\_\_\_\_  
NE NE SE  
 Geol. \_\_\_\_\_  
 Contr. \_\_\_\_\_  
Co. Tools  
 Pool \_\_\_\_\_  
Lorado



Date Comm. 5/31/58  
8" @ 242 Orlg. 152R

No. \_\_\_\_\_  
 Sec. \_\_\_\_\_  
 T. \_\_\_\_\_  
 R. \_\_\_\_\_

# CORRECTION

Twp. ~~\_\_\_\_\_~~ Pool ~~\_\_\_\_\_~~  
 Co. ~~\_\_\_\_\_~~ Facet ~~\_\_\_\_\_~~

5-513 B

County Reno Elev. 1701 DE  
 Sec. 16 Twp. 26 Rge. 9N  
 Company Messman-Kinehart  
 Form Name Saylor-Jones Unit No. 1

TOPS	DEPTH	LOG	DATUM
Anh.			
Tp.			
H.			
Tr.			
Dg.			
B.L.			
L.			
K.C.			
B.K.C.			
Ce.			
C.			
M. <u>Chat</u>	<u>3922</u>		
M. <u>Li</u>	<u>3972</u>		
K.			
Mz.			
Mq.			
V.			
S.			
S.			
A.			
R.			
Pf.			
G.			
T.D.	<u>3976</u>		

Loc. in Sec. \_\_\_\_\_  
~~NE NE SW~~  
~~NE SE NE~~  
 Geol. \_\_\_\_\_  
 Contr. \_\_\_\_\_  
 Co. Tools \_\_\_\_\_  
 Pool \_\_\_\_\_  
 Lerado \_\_\_\_\_

**ABANDONED**  
 JUN 11 1958

Date Comm. 5/31/58  
8" @ 242 Dr/c. 152R JUN 11 1958 DST 3918-36  
90" 250' M 250' SW NO BMP.

D6A

Use. No. Sec. T. R.