

O. W. P. B.

FORM 51 5M 11-44 PETROL


KANSAS

Reno County

Section 21 Township 26 Range 9W

Well No. #1 Guyson

Company Phillips

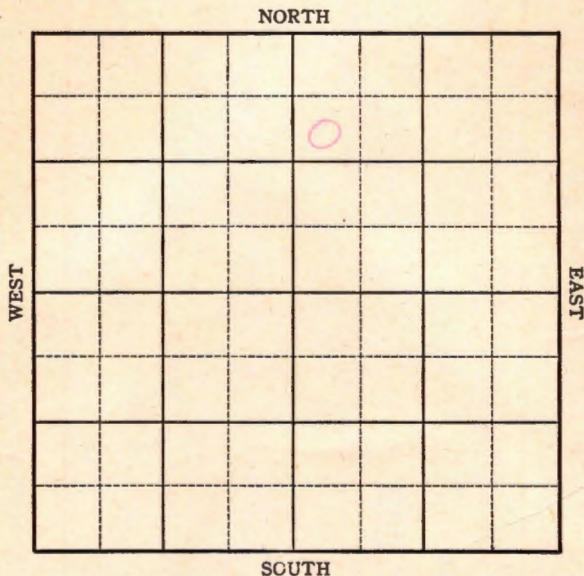

O.W.P. KANSAS

Reno County

Sec. 21 Twp. 26 R. 9W

Well No. #1 Guyson Farm
Phillips Company


Lerado

990 Ft. from N. Line

 Ft. from S. Line

 Ft. from E. Line

330 Ft. from W. Line

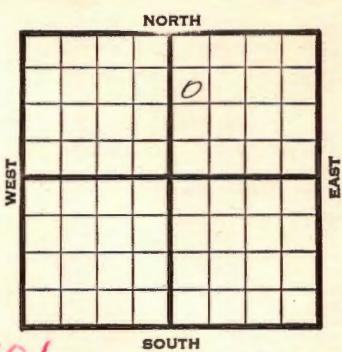

SW NW NE *Elev. 1701*

1945

REPORT

3/28	Location
4/5	"
4/12	"
4/20	"
4/27	Derrick
5/3	"
5/10	8" @ 417' WOC
5/17	Drlg. 2100'
5/24	Lans 3365
	Drlg. 3438'
5/31	Miss 3896
	Kind 3954
	Viola 4161
	Drlg. 4166mSat.
6/8	5" @ 4161 TD 4169 Swb. 5 oil P.H. 10 hrs.
6/14	" " " " " "
6/21	" " " " " "
6/28	Pump 225 oil in 13 hrs
7/11	Viola 4161 5" @ 4161 2300 acid. TD 4169' Pump 296 Pot. Grav. 39

**COMPLETED
OVER**

1952
4/2

O. W. P. B.
Lans. 3365

V 4161'

TD 4169'

5" @ 4161' was V Prod.

RUST To PB & Perf KC

4/9

Set plug 3585 16/3556-60

12/3550-53 16/3543-47

16/3536-50 16/3532-36

500 A S/1-3/4 BO & 6BW 2 hrs.

1500 A S/4 $\frac{1}{2}$ BO & 15 BW 6 hrs.

Set plug 3528 4/3500-3501 wtr.

Set plug 3575 40/3446-56

28/3435-42 28/3410-17 1000 A

B/1-3/4 BO & 15 BW 7 hrs.

Set plug 3290 16/3246-50 150 BW 5 hrs.

4/16

D&A TD 3290

Lans. 3365 Viola 4161 TD 4169

5" @ 4161 SP 3585

16/3556-60 12/3553-56

16/3543-47 16/3536-40

16/3532-36 500 A S/1-3/4 bo 6 bw

2 hr. 1500 A S/4 $\frac{1}{2}$ bo 15 bw 6 hrs.

SP 3528 4/3500-3501 wtr

SP 3475 40/3446-56 28/3435-42

28/3410-17 1000 A B 1-3/4 bo

15 bw 7 hr. SP 3290 16/3246-50

150 bw 5 hr. D&A

ABANDONED

KANSASKansas Pool Name LoradoMap No. 41 Sec. 21 Twp. 26 R. 9WWell No. 1 GuysonPhillips Company**COMPLETED** Contractor

SW NW NE

E 11701
SECTION PLAT990 Ft. from N. Line Ft. from S. Line Ft. from E. Line330 Ft. from W. Line

		0	

Reno County

Location Rig up

Drilling and Remarks:

Vista 41615" @ 41612800 acidProd 296 St.29 St.**RECORD**Cased in., ft.Sand Gas Oil Total Depth 4165**PRODUCTION**1st 24 hrs. Nat. 1st 24 hrs. after shot Gas Cu. Ft.Dry Hole Abandoned

Date

JUL 11 1945 19S. J. LEWIS Scout

Pool Name LeradoMap No. 41 Sec. 21 Twp. 26 R. 9WWell No. 1 GuysonPhillips


Company

FIRST REPORT

Contractor

SW NW NE

SECTION PLAT

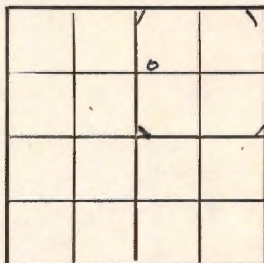990 Ft. from N. Line

Ft. from S. Line

Ft. from E. Line

330 Ft. from W. LineRenoLocation X

Rig up

Drilling and Remarks:

RECORD

Cased _____ in., _____ ft.

Sand _____

Gas _____

Oil _____

Total Depth _____

PRODUCTION

1st 24 hrs. Nat. _____

1st 24 hrs. after shot _____

Gas _____ Cu. Ft.

Dry Hole _____

Abandoned _____

Date

MAR 28 1945 19S. J. LEWIS

Scout

O. W. P. B.

County **Reno** State **Kansas**Sec. **21** (Blk. Twp.) **26** (Sur. Rge.) **9W** Map No.Operator **Phillips**Well No. **1** Farm **Guyson**Elev. **1701** Location **SW NW NE**

0

FIRST REPORT

990 Ft. From **N** Line **NE**330 Ft. From **W** Line **Quarter**1st. Report **APR 2 1952**

Completion

Remarks **OWPB**

O. W. P. B.

Spudding Date

Drlg. Data

Lens **3365 V 4161 TD 4169 5" @ 4161**was V prod. Rust to PB & Perf. **KC**

J. G. McGEHEE

J. G. McGEHEE