


Reno
KANSAS

Section.....15.....Township.....26.....Range 9W.....

Well Number.....3.....W. Whipple.....

Company.....Shell.....

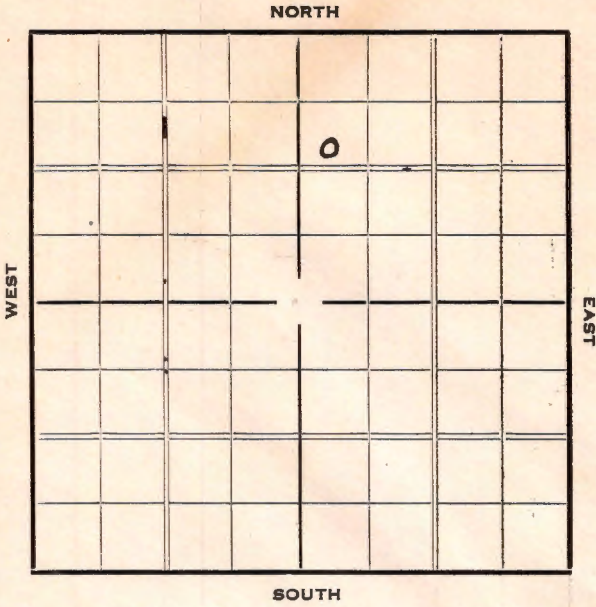

Map No. 41 Sec. 15 Twp. 26 R. 9W.

Well No. 3 M Whipple

Shell Company

Contractor

SECTION PLAT

		6	

1002 Ft. from N. Line

_____ Ft. from S. Line

_____ Ft. from E. Line

330 Ft. from W. Line

COMPLETED

Location _____

Rig up _____

Drilling and Remarks:

Viola 4/36
2000 acid
P 85014

RECORD

Cased _____ in., _____ ft.

Sand _____

Gas _____

Oil _____

Total Depth 4144

PRODUCTION

1st 24 hrs. Nat. _____

1st 24 hrs. after shot _____

Gas _____ Cu. Ft.

Dry Hole _____

Abandoned _____

Date

DEC 29 1936

S. J. LEWIS

Scout

Map No. 41 Sec. 15 Twp. 26 R. 9WWell No. 3 M WhippleShell Company

Contractor

SECTION PLAT

		0	

1002 Ft. from N. Line

_____ Ft. from S. Line

_____ Ft. from E. Line

330 Ft. from W. Line

FIRST REPORT

Location _____

Rig up _____

Drilling and Remarks:

12 1/2 @ 320 WOC

RECORD

Cased _____ in., _____ ft.

Sand _____

Gas _____

Oil _____

Total Depth _____

PRODUCTION

1st 24 hrs. Nat. _____

1st 24 hrs. after shot _____

Gas _____ Cu. Ft.

Dry Hole _____

Abandoned _____

Date

NDV 1 8 1936 19

S. J. LEWIS Scout