

KANSAS


FORM 51 5M PETROL

Reno

Section 16 Township 26 Range 9W

Well No. #1 Montiford

Company Phillips

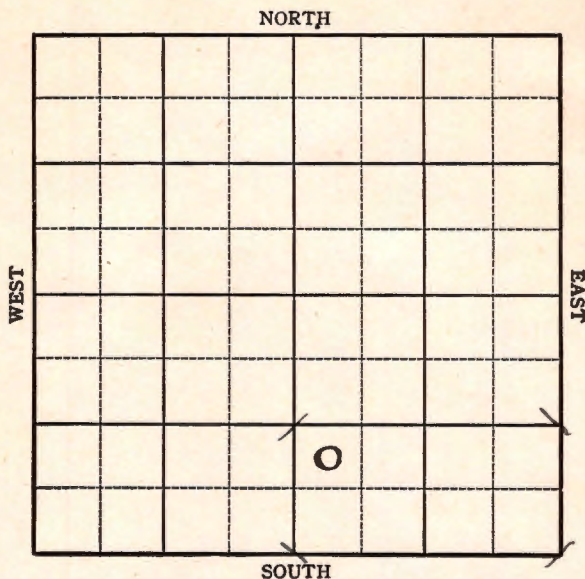

KANSAS
FORM 252-A
MAY 1944 PETROL

Reno

Sec. 16 Twp. 26 R. 9W

Well No. #1 Montiford Farm

Phillips Company

Lerado


_____ Ft. from N. Line

990 Ft. from S. Line

_____ Ft. from E. Line

330 Ft. from W. Line

Elev. 1702

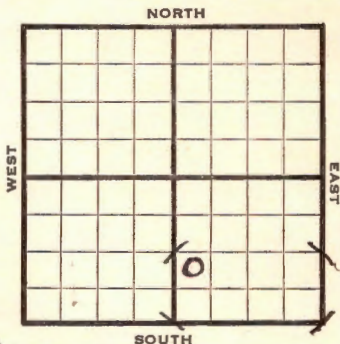

1944

REPORT

- 4/12 Rotary
- 4/19 **Lans 2699**
TD 3730 Fsg.
- 4/26 Drlg. 1880
- 5/3 **Lans 3379**
Drlg. 3549'
- 5/10 **Mibs 3914**
Kind 3970
Viola 4180-95
TD PB 3685
5" @ 3685 RUST
- 5/17 5" - 3698 (Corrected)
RUST
- 5/24 TD 3704 No Shows
- 5/31 " " " "
- 6/7 5" @ 3698
Viola 4180
TD 4195
Water

ABANDONED

KANSAS

Pool Name Lorado

Map No. 47 Sec. 16 Twp. 26 R. 9W

Well No. 1 Montford

Phillips

Company

ABANDONED

Contractor

NW SW SE

SECTION PLAT

_____ Ft. from N. Line

990 Ft. from S. Line

_____ Ft. from E. Line

330 Ft. from W. Line

		6	

Reno County

Location _____

Rig up _____

Drilling and Remarks:

*Vista #180
5" @ 3698'
Water.*

RECORD

Cased _____ in., _____ ft.

Sand _____

Gas _____

Oil _____

Total Depth 4185

PRODUCTION

1st 24 hrs. Nat. _____

1st 24 hrs. after shot _____

Gas _____ Cu. Ft.

Dry Hole _____

Abandoned _____

Date

JUN 7 1944 19

S. J. LEWIS Scout

