

Reno

**KANSAS**


SECTION 16 TOWNSHIP 26S RANGE 9W

WELL NO. #1 Montford "C"

COMPANY Messman-Rinehart

NORTH

~~NE~~ ~~SE~~ ~~NE~~

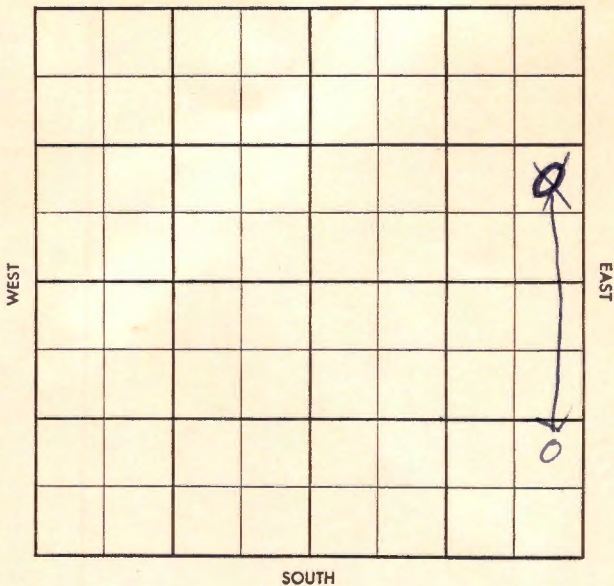



Twp. ~~X~~ Pool ~~X~~

Co. ~~X~~ Facet ~~X~~

**CORRECTION**

S-513-B

County Reno Elevation 1690  
 Sec. 16 Twp. 26 Rge. 9W  
 Company Messman-Rinehart  
 Farm Name Montford "C" No. 1

TOPS	DEPTH	LOG	DATUM
Anh.			
Tp.			
H.			
Tr.			
Dg.			
B.L.	<u>3340</u>		
L.	<u>3372</u>		
K.C.			
B.K.C.			
Ce.			
C.			
M. <u>ch.</u>	<u>3886</u>		
M.			
K.			
Mz.			
Mq.			
Y.	<u>4154</u>		
S.			
S.			
A.			
R.			
Pf.			
G.			
T.O.	<u>4157</u>		

Loc. in Sec. NE SE NE  
~~NE SE NE~~  
~~NE SE NE~~

Geol. \_\_\_\_\_  
 Contr. \_\_\_\_\_  
Co. tools

Pool Lerado

**COMPLETE**

MAY 28 '58

Date Comm. 4-16-58 8" 233

Location APR 23 '58 D 2941 APT 90 '58

DST 3528-52 1 hr. 350' GIP

255' gem BHP 960/30"

DST 3578-3650 1 hr. 300' gem

BHP 1360 DST 4151-57 45"

2500' GIP 80' wht + gem

BHP 1060 5" e 4156/176 MAY 7 '58

DD 4159 TD \$ 2 1/2 BOPH 3 hrs 250x

\$ 8 BFP Ph wtr inc MAY 1 '58 \$ 6 BOPH 250x pl

PB 24/3890 - 96 Acid

MAI W1 50 MAY 23 58 <sup>from 5000</sup>

est 8.000 - <sup>from 5000</sup> + 25 B0

50 BW pd from nicole

Dual completion

PKR 4000

16-26-9W

Wase