


Section 18 Township 26 Range 9 W

Well No. #1 Wells

Company Sohio Pet. Co.

NORTH

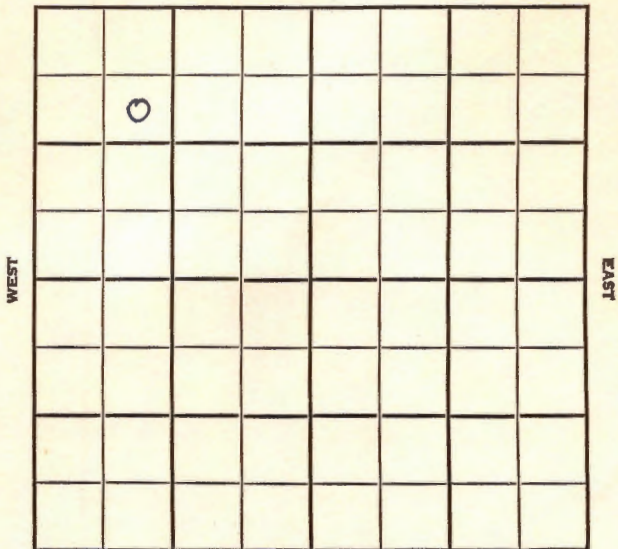

SOUTH

Reno

KANSAS

SEC.	TWP.	R.
18	26S	9W

WELL NO.

#1 Wells

FARM

COMPANY

Sohio Pet. Co.

CONTRACTOR

B & B


Wildcat

_____ Ft. from N. Line

_____ Ft. from S. Line

_____ Ft. from E. Line

_____ Ft. from W. Line

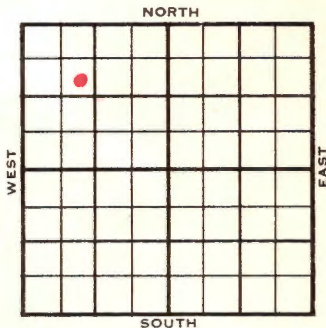

SE NW NW
DS-SW/4

	ELEVATION	REPORT
1955	1661'	
7/20	Comm: 7/18/55 8" w/200 WOC	
8/3	DS ⁺ 3761-91 open 1 hr. Rec. 26' mud 105/20" TD 4418 D&A	
	H. 3225	1564
	BL 3411	1750
	L. 3428	1767
	M. 3918	2257
	K. 3986	2325
	V. 4191	2530
	S. 4274	2613
	A. 4366	2705
	TD. 4418	

ABANDONED

County Reno Elev. _____
 Sec. 18 Twp. 26S Rgs. 9W
 Company Sohio Pet. Co.
 Farm Name Wells No. 1

Co.

TOPS	DEPTH	LOG	DATUM
Anh.			
Tp.			
H.			
Tr.			
Dg.			
Bl.			
L.			
K.C.			
B.K.C.			
Ce.			
C.			
M.			
M.			
K.			
Mz.			
Ma.			
V.			
S.			
S.			
A.			
R.			
PE.			
G.			
T.D.			

Loc. in Sec. _____
SE NW NW
DS-NW/4
 Geol. _____
 Contr. B & B
 Pool _____
W.C.

Lse.



No.

Date Comm. 7/18/55
8th 356 w/200 WOC

Sec.

T.

27

R.

County Reno Elev. 1661
 Sec. 18 Twp. 26 Rgs. 9W
 Company Sohio Pet.
 FarmName Wells No. 1

Co.

TOPS	DEPTH	LOG	DATUM
Anh.			
TP.			
H.	3225		1564
Tr.			
Dg.			
BL.	3411		1750
L.	3428		1767
K.C.			
B.K.C.			
Ce.			
C.			
M.	3918		2257
M.			
K.	3986		2325
Mz.			
Mq.			
V.	4191		2530
S.	4274		2613
S.			
A.	4366		2705
R.			
PE.			
G.			
TD.	4418		

Loc. in Sec. SE NW NW

Geol. _____

Contr. B & B

Pool Wildest

ABANDONED

Sec.

No.

Sec.

T.

R.

Date Comm. 7-18-55 AUG 3 1955
8" @ 356/200 DST 3761-91 open 1 hr.
Rec. 26' mud 105/20" TD 4418
D & A