


Reno

KANSAS

SECTION 20 TOWNSHIP 26S RANGE 9W

WELL NO. #1 Woodson

COMPANY Messman-Rinehart

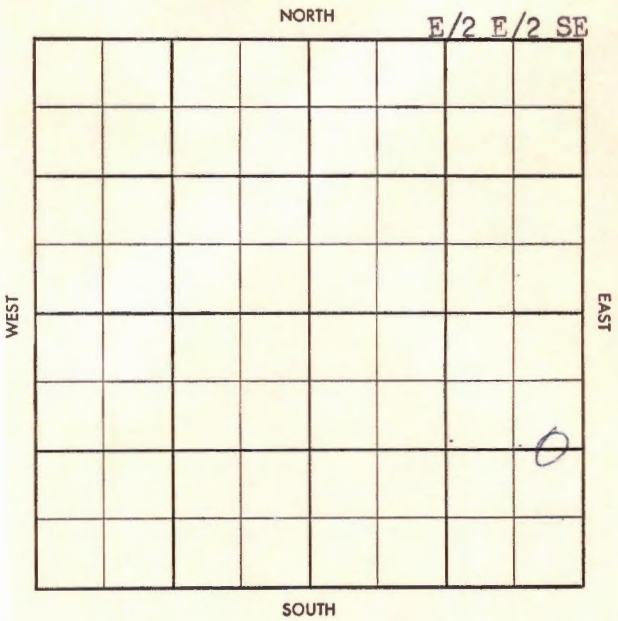

~~25~~

County Reno Elev. _____
 Sec. 20 Twp. 26 Rge. 9W
 Company Messman-Rinehart
 Farm Name Woodson No. 1

TOPS	DEPTH	LOG	DATUM
Anh.			
Tp.			
H.			
Tr.			
Dg.			
B.L.			
L.			
K.C.			
B.K.C.			
Ce.			
C.			
M.			
M.			
K.			
Mz.			
Mq.			
V.			
S.			
S.			
A.			
R.			
Pf.			
G.			
T.D.			

Loc. in Sec. _____

$E\frac{1}{2}$ $E\frac{1}{2}$ SE

Geol. _____

Contr. _____

Co. tools

Pool _____

Lerado



Date Comm. _____

Location

Co.

Lse.

NO.

Sec.

T.

R.

Twp. ~~Pool~~
 Co. ~~Facet~~

9-513-B

County Reno Elev. 17180 or 17218B
 Sec. 20 Twp. 26 Rge. 9th
 Company Messman-Rinehart
 Farm Name Woodson No. 1

TOPS	DEPTH	LOG	DATUM
Anh.			
Tp.			
H.			
Tr.			
Dg.			
B.L.	<u>3383</u>		
L.	<u>3420</u>		
K.C.			
B.K.C.			
Ce.			
C.			
M.	<u>3927</u>	<u>3926</u>	
M.			
K.			
Mz.			
Mq.			
V.		<u>419B</u>	
S.			
S.			
A.			
R.			
Pf.			
G.			
T.D.	<u>4230</u>		

Loc. in Sec. E 1/4 SE
 Geol. _____
 Contr. _____
 Co. tools _____
 Pool Lerado

COMPLETE	
MAY 7 '58	0

Date Comm. 3-29-58 8" 230
 Location MAR 10 '58 62130

APR 9 '58 Ø 3383 DST 3927 4200
1hr 9 1/2" ga 362 maf / 15" ga
4 7/8" maf / 60" rec 185' gem
FP 95-105 BHP 1375 / 20" APR 16 '58
10g 5" 24238 WOC APR 23 '58 CO
20 / 3925-30 300A 4st 1.200
maf from Fl 2.000 maf CP 920
TP 920 APR 20 '58 MAY 7 '58 DP P10 ga 3.500 maf
51CP1263

Co.
 No.
 Sec.
 T.
 R.