Reno KANSAS


Form 51-5M 5-37 Petrol

O.W.W.O.

Section 22 Township 26 Range 9-W

Well No. ~~1 - Shepherd~~ #1 Reece - Nunemaker

Company ~~Albert Jones et al~~ Meseman & Rinehart

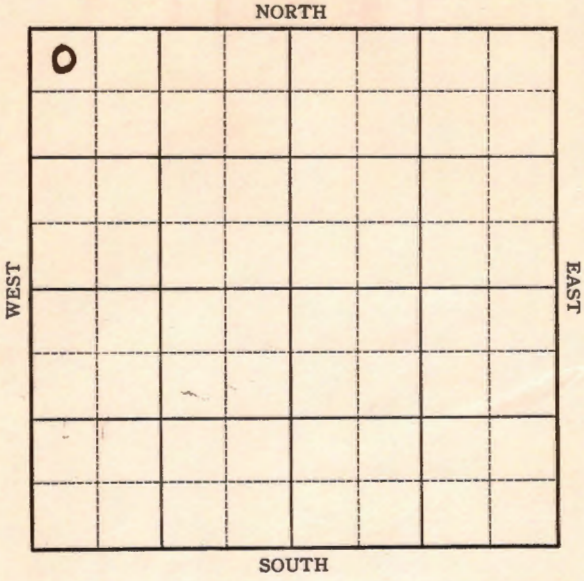

Form 252-A—5M—2-37—Palace KANSAS Reno

Sec. 22 Twp. 26 R. 9-W

Well No. #1 Shepherd Farm


Albert Jones et al Company

330 Ft. from N. Line

Ft. from S. Line

Ft. from E. Line

330 Ft. from W. Line

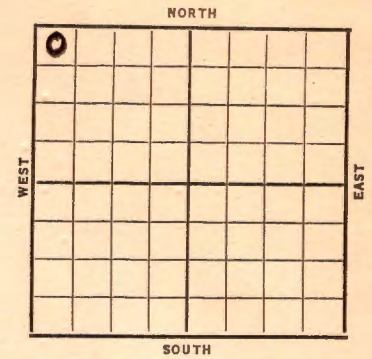

Elev. 1688

Date	REPORT
1937	
8/18	R. R.
8/28	R U R
9/3	"
9/10	12" @ 310'. Drlg. 400'.
9/17	Drlg. 2239'.
9/24	K.C. 3360'. Drlg. 3366'.
10/2	S.O. 3534-39'. Drlg. 3710'.
10/8	Chat 3889' no shows.
	Viola 4150'. 7" @ 4150'.
	T.D. 4153'. Stain oil 4151-53'.
10/15	400' Fluid. P.B. 4152'.
	1000 acid.
10/22	1750' water & 400' oil.
	P.B. 3575'.
10/29	" "
11/5	" "

OVER

1937

11/10 7" @ 4150'.

Viola 4150'.

T.D. 4153'.

1000 acid.

1750' water & 400' oil.

P.B. 3587'.

3000 acid.

Shot 5 qts.

Swab 50 bbls. oil & 150 bbls. water per day.

ABANDONED

1938

6/29--Old Abd. hole
Cleaned out and put on pump
Last test before poten. 40 oil & 88 wat. in 8 hrs.
On poten. pumped 41/4 & 29/4
Poten. 173
No gauge on wtr.

FIRST REPORT

COMPLETED

Form 26—1M Bks.—2-29 Reno KANSAS

Map No. 41 Sec. 22 Twp. 26 R. 9W

Well No. 1 ~~Shepperd~~ Shepherd

Albert & Jones Company

FIRST REPORT

COMPLETED Contractor

NW/C


330 Ft. from N. Line

_____ Ft. from S. Line

_____ Ft. from E. Line

330 Ft. from W. Line

SECTION PLAT

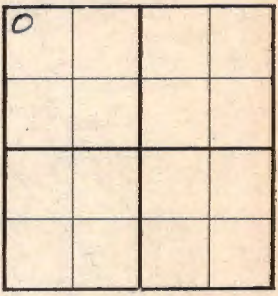

Location _____

Rig up _____

Drilling and Remarks:

Old Abd.Hole
Cleaned out and
put on pump.
Last test before
poten. 40 oil &
88 wat.in 8hrs
on poten. pumped
41/4 &29/4
Poten. 173
No Guage on WTR

RECORD

Cased _____ in., _____ ft.

Sand _____

Gas _____

Oil _____

Total Depth _____

PRODUCTION

1st 24 hrs. Nat. _____

1st 24 hrs. after shot _____

Gas _____ Cu. Ft.

Dry Hole _____

Abandoned _____

Date

JUN 29 1938

19

H. D. Hatfield Scout

Form 26—1M Bks.—2-29

Reno KANSAS

Map No. 41 Sec. 22 Twp. 26 R. 9W

Well No. 1 Shepherd

Albert Jones Company

ABANDONED Contractor

NW/C


330 Ft. from N. Line

____ Ft. from S. Line

____ Ft. from E. Line

330 Ft. from W. Line

SECTION PLAT

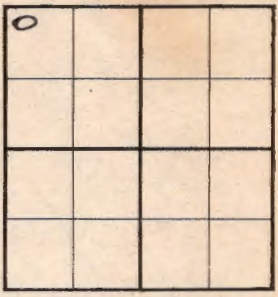

Location ____

Rig up ____

Drilling and Remarks:

1000 Acid

1750' water 4400' oil

P.B. 3587

3000 Acid

Shot 5 qts

Swb 50 bbls oil 4150

D & A

RECORD

Cased 7 in., 4150 ft.

~~Sand~~ Viola 4150

Gas ____

Oil ____

Total Depth 4153

PRODUCTION

1st 24 hrs. Nat. ____

1st 24 hrs. after shot ____

Gas ____ Cu. Ft.

Dry Hole ____ bbls water Per day

Abandoned ____

Date

NOV 10 1937 19 H. D. Hatfield Scout

Form 26—1M Bks.—2-29 Reno KANSAS

Map No. 41 Sec. 22 Twp. 26 R. 9W

Well No. 1 — Shepherd

albert Jones etal Company

Contractor

FIRST REPORT


330 Ft. from N. Line

_____ Ft. from S. Line

_____ Ft. from E. Line

330 Ft. from W. Line

SECTION PLAT

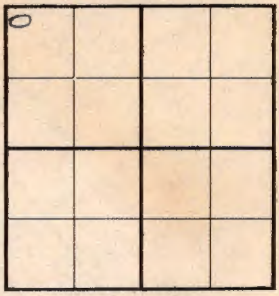

Location _____

Rig up _____

Drilling and Remarks:

R.R.

RECORD

Cased _____ in., _____ ft.

Sand _____

Gas _____

Oil _____

Total Depth _____

PRODUCTION

1st 24 hrs. Nat. _____

1st 24 hrs. after shot _____

Gas _____ Cu. Ft.

Dry Hole _____

Abandoned _____

Date

AUG 18 1937 19____

H. D. Hatfield Scout

27 O.W.W.O.

S-513-A

CO. Reno ELEV. 1688

SEC. 22 TWP. 26 RGE. 9W

COMPANY Messman & Rinehart 1

OCT 23 '67

FIRST REPORT

FARM Reece-Hunemaker (O.W.W.O.)

LOC. NW NW NW

O.W.W.O.

GEOL.

CONTR.

POOL Lerado

SPUD

~~Old Info. Old Tops Lans. 3360, Miss 3889, Vi 4150~~
~~OTD 4153, 7" @ 4150 was Lans. Prod. Old Operator~~
was A. Jones
NEW INFO. MIRT Co. Tools
rig #2 CO 3995, 4" @ 3995, w/50, WOCT

CO. LSE. NO. SEC. TWP. RGE.

O.W.W.O.

S-513-A

CO. Reno ELEV. 1688

SEC. 22 TWP. 26 RGE. 9W

COMPANY Messman & Rinehart 1 NO.

NOV 6 57

COMPLETE

(O.W.W.O.)

FARM Reece-Hunemaker

LOC. NE NW NW

GEOL.

CONTR.

POOL Lerado

SPUD

Old Info. Old Tops Lans. 3360, Miss 3889, Vi 4150, OCD 4153, 7" @ 4150 was Lans. Prod. Old Op. was A. Jones

NEW INFO. MTRT Co. Tool rig #2 CO 3995, 4" @ 3995, w/50, MCF w o ct CO GRN Log

Michert 3882 M Li 3937

20/3883-88 frac SX

flo ga 2,300 mcf pd

miss 3883-88

TD 4153

CO. LSE. NO. SEC. TWP. RGE.