

KANSAS


Reno

FORM 51 5M PETROL

Section 21 Township 26 Range 9 W

Well No #1 Saylor W/ YMAN

Company Phillips

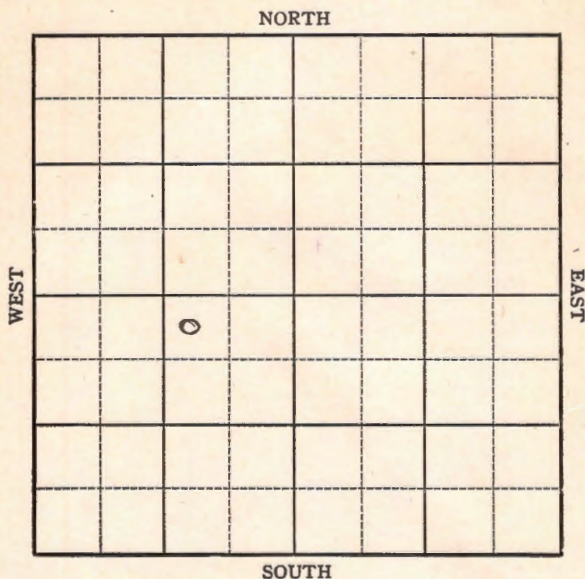


Sec. 21 Twp. 26 R. 9-W

Well No. #1 Saylor WYMAN Farm

Phillips Company

NORTH

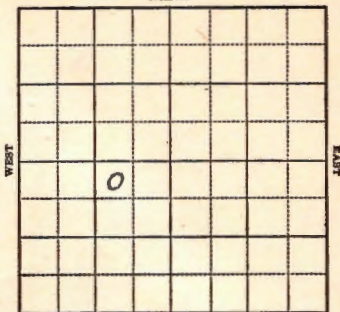

330 Ft. from N. Line

Ft. from S. Line

990 Ft. from E. Line

Ft. from W. Line

Elev. 1712

REPORT

1943

12/1 Location.

12/8 8" @ 399
WOC

12-15 Drlg. 2280'

12/22 **Lans 3390**
SSO 3446-50, 3464-68
Drlg. 3482'

12/29 **Miss 3916**
Drlg 3973

1944

1-5 **Viola 4177-81**
TD 5" @ 4177
Rust

1-12 TD 4182 swb 16 oil in 5 hrs.

1/19 TD 4188-2200' oil

1/26 " " " "

2/2 " " "

2/8 " " "

2/15 " " "

OVER

1944

2/23

5" @ 4177

Viola 4177

TD 4188

Pump 93 Pot.

Gravity 39.2

COMPLETED

KANSAS

Map No. 41 Sec. 21 Twp. 26 R. 9WWell No. 1 SaylorPhillips


Company

FIRST REPORT

Contractor

NW NE SW

SECTION PLAT

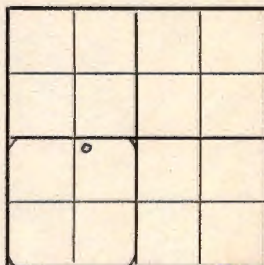330 Ft. from N. Line Ft. from S. Line990 Ft. from E. Line Ft. from W. Line

Wildcat

Location XRig up

Drilling and Remarks:

RECORD

Cased in., ft.Sand Gas Oil Total Depth

PRODUCTION

1st 24 hrs. Nat. 1st 24 hrs. after shot Gas Cu. Ft.Dry Hole Abandoned

Date

DEC 1 1943 19

S. J. LEWIS Scout

KANSAS
 Map No. 41 Sec. 21 Twp. 26 R. 9W

Well No. 1 Wyman

Phillips Company

CORRECTION Contractor

NW NE SW


330 Ft. from N. Line

 Ft. from S. Line

990 Ft. from E. Line

 Ft. from W. Line

SECTION PLAT

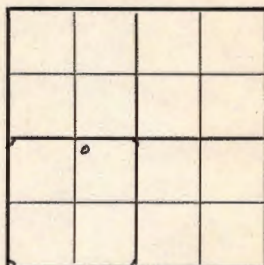

Wildcat

Location

Rig up

Drilling and Remarks:

Reported

#1 Saylor

RECORD

Cased in., ft.

Sand

Gas

Oil

Total Depth

PRODUCTION

1st 24 hrs. Nat.

1st 24 hrs. after shot

Gas Cu. Ft.

Dry Hole

Abandoned

Date

DEC 8 1943 19

S. J. LEWIS Scout

Map No. **KANSAS** Sec. **21** Twp. **26** R. **9W**

Well No. **1 Wyman**

Phillips

Company

COMPLETED

Contractor

NW NE SW

SECTION PLAT

330


Ft. from N. Line

Ft. from S. Line

990

Ft. from E. Line

Ft. from W. Line

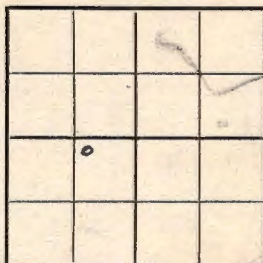

Wildcat

Location

Rig up

Drilling and Remarks:

Viola 4177

5" @ 4177

Prod 93 Bx

392 1/2

RECORD

Cased _____ in. _____ ft.

Sand _____

Gas _____

Oil _____

Total Depth *4188*

PRODUCTION

1st 24 hrs. Nat. _____

1st 24 hrs. after shot _____

Gas _____ Cu. Ft.

Dry Hole _____

Abandoned _____

Date

FEB 23 1944 19

S. J. LEWIS Scout