


Section 26 Township 26 Range 9W
Well No. 1 Jones
Company Harms & Burt Drlg. et al

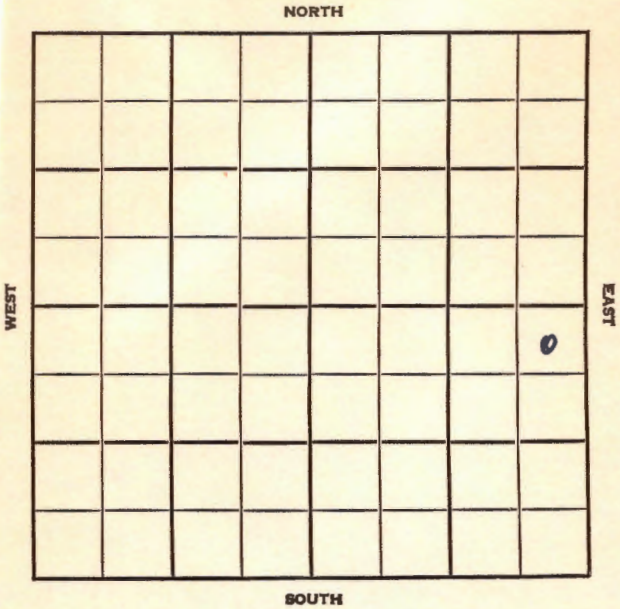

Reno KANSAS

SEC.	TWP.	R.
26	26	9W

WELL NO.

1 Jones

FARM

COMPANY

Harms & Burt Drlg. et al

CONTRACTOR


Co. Tools
Wildcat

330 Ft. from N. Line

Ft. from S. Line

330 Ft. from E. Line

Ft. from W. Line

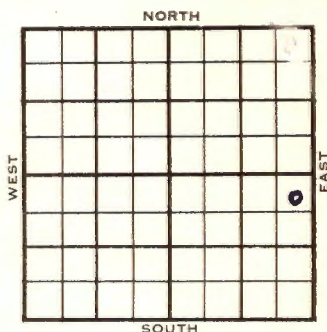

NE NE SE

	ELEVATION	REPORT
1954	1668'	

11/10

MIR

12/1

Spud 11-9-54 D & A TD 4433
 8" @ 210 Heeb 3179 Tor. 3210
 Doug 3255 Br line 3345 Lans 3360
 Miss. 3944 Kh. 4007 Chattanooga
 4140 Viola 4211 Simp. sh. 4288
 Simp. sd 4294
 DST 4209-21 open 1 hr rec 115' SW
 1230#
 DST 4287-4305, open 1 hr rec 10' mud
 66# Arb. 4394
 DST 4378-4433 open 1 hr rec 3230' SW
 1653# TD 4433' D & A

ABANDONED

County **Reno** State **Kansas**

Sec. **26** (Blk.) **26** (Sur.) **9W** Map No.

Operator **Harms & Burt Drlg. etal.**

Well No. **1** Farm **Jones**

Elev.	Location	NE NE SE
330 Ft. From N Line SE

380 Ft. From E Line Quarter

1st. Report NOV 10 1954

Completion

Remarks


Co. tools

Spudding Date _____

Drig. Data **Wildcat**

MIR

FABEN GILSTRAP

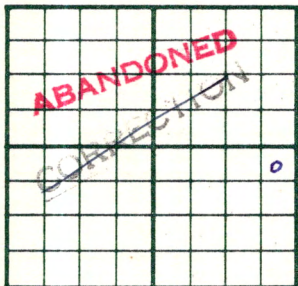County Reno State KansasSec. 26 (Blk.
Twp.) 26 (Sur.
Rge.) 9W Map No.Operator Harms & Burt Drlg. etal.Well No. 1 Farm JonesElev. 1668 Location NE NE SE330 Ft. From N Line SE330 Ft. From E Line Quarter

1st. Report _____

Completion DEC 1 1954Remarks WildcatCo. toolsSpudding Date 11-9-54Drlg. Data D & A TD 44338" @ 210 Heeb. 3179 Tor. 3210Doug. 3255 Br. lime 3345 Lans. 3360Miss. 3944 Kh. 4007 Chattanooga 4140Viola 4211 Simp. sh. 4288 Simp. sd. 4294DST 4209-21 open 1 hr. Rec. 115' sw1230# DST 4287-4305 open 1 hr.Rec. 10' mud 66# Arb. 4394DST 4378-4433 open 1 hr. Rec. 3230' sw1653# TD 4433D & A

FABEN GILSTRAP