

Reno

KANSAS

SECTION 28 TOWNSHIP 26S RANGE 9W

WELL NO. #1 Woodson


COMPANY Bradley-Rio Hondo

NORTH

C NW NE

WEST

EAST

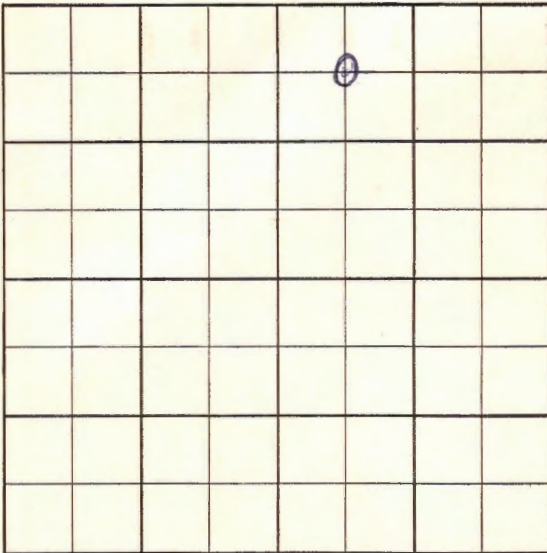

SOUTH

~~Twp~~ ~~Pool~~
~~Co~~ ~~Facet~~

S-513-B

County Peno Elev 1704 OF 1707 RB
 Sec. 28 Twp. 26 Rge. 9W
 Company Bradley-Rio Hondo
 Farm Name Woodson No. 1

TOPS	DEPTH	LOG	DATUM	Loc. in Sec.
Anh.				C NW NE twin
Tp.				
H.	3204			
Tr.				
Dg.				
B.L.				
L.	3398			
K.C.				Geol.
B.K.C.				Contr.
Ce.				
C.				
M.	3914			
M.				Pool
K.				Lerado
Mz.				
Mq.				
V.				
S.				
S.				
A.				
R.				
Pf.				
G.				
T.D.	3960			

Date Comm. 5-25-58
8" @ 300/175 drlg. 1805 JUN 3 '58 @ 3960
JUN 11 '58 end 3916 - 37 sec 15'
DST 3916 - 37 @ 80" ga 84 m/f
65' gum BHP 1415 DST 3920-32
ap' hr ga 98 m/f 160" 30' gum
120 MW BHP 1335 5" 3959 JUN 18 '58
20/3917 - 21 ga 40 m/f (1/2) ga 250
m/f trace 4X3 ga 1.250 m/f
+ 2 1/2 BS PD 5900 il + 5 + 9 JUN 25 '58
JUL 2 '58

AL 8:58 AL 15:58 P & D L O H 2, 380
 May S I C P 1259
 M 3917 - 21


Tw. ~~26~~ Rge. ~~9W~~

S-513-B

County Reno Elev. _____
Sec. 28 Twp. 26 Rge. 9W
Company Bradley-Rio Hondo
Farm Name Woodson No. 1

TOPS	DEPTH	LOG	DATUM
Anh.			
Tp.			
H.			
Tr.			
Dg.			
B.L.			
L.			
K.C.			
B.K.C.			
Ce.			
C.			
M.			
M.			
K.			
Mz.			
Mq.			
V.			
S.			
S.			
A.			
R.			
Pf.			
G.			
T.D.			

Loc. in Sec. _____
C NW NE
twin
Geol. _____
Contr. _____
Pool _____
Lorado

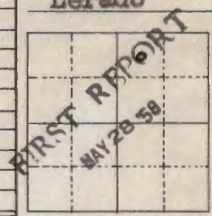

Date Comm. 5-25-58
8" @ 300/175 drlg. 1805

Co.
Lse.
No.
Sec.
T.
R.