

# KANSAS

Form 51-5M-7-40-Palace


Reno

Section 28 Township 26 Range 9-W

Well No. 1 Woodson

Company Bay Petroleum

NORTH **Wildcat**

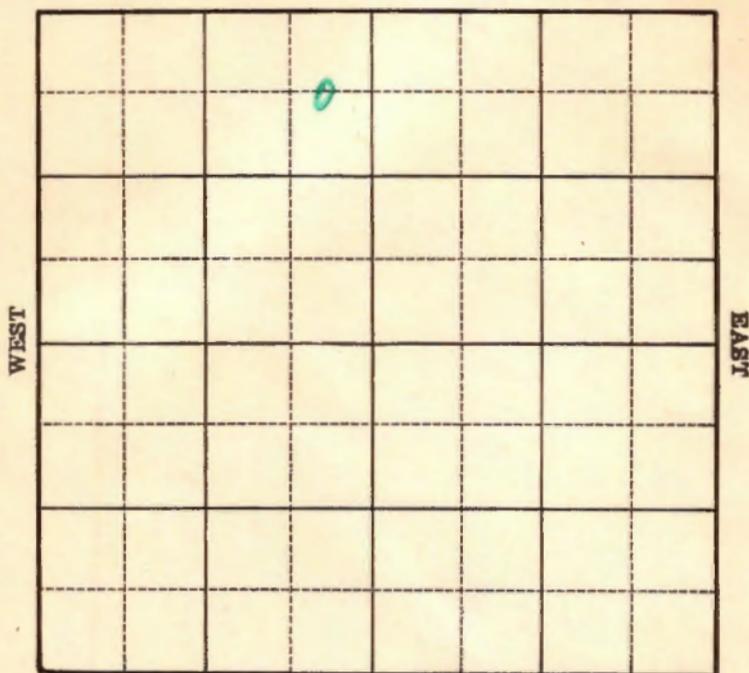

SOUTH

Sec. 28 Twp. 26 R. 9-W

Well No. #1 Woodson Farm

Bay Petr. Company


(Wildcat)

660 Ft. from N. Line

\_\_\_\_\_ Ft. from S. Line

330 Ft. from E. Line

\_\_\_\_\_ Ft. from W. Line

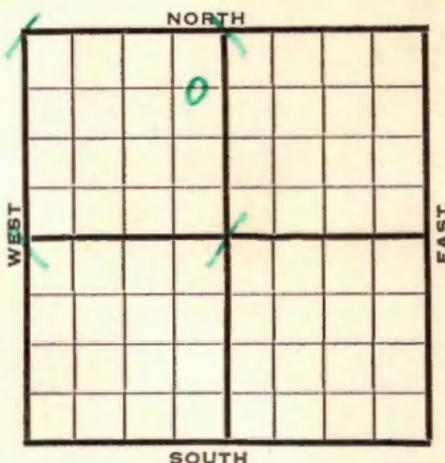

**Elev. 1712**

1941	REPORT
1/29	Location
2/6	"
2/13	Derrick.
2/20	10" - 259' Anhy 510' Drlg. 2238'
2/27	Ft. Riley 1685' Lans. 3390' Drlg. 3949'
3/6	Miss. 3914' Viola 4185' Simp. sand 4253' Arb. 4358-77' T.D. Shut down.
3/12	Arb. 4358' T.D. 4377' No shows.
	<b>ABANDONED</b>

Map No. 41 Sec. 28 Twp. 26 R. 9WWell No. 1 WoodsonBay Petroleum Company

Contractor

ABANDONED

C E L N E N W

660 Ft. from N. Line

\_\_\_\_\_ Ft. from S. Line

330 Ft. from E. Line

\_\_\_\_\_ Ft. from W. Line

WILDCAT

## SECTION PLAT

	0		

Location \_\_\_\_\_

Rig up \_\_\_\_\_

Drilling and Remarks:

*Oil 4358**No shows*

## RECORD

Cased \_\_\_\_\_ in., \_\_\_\_\_ ft.

Sand \_\_\_\_\_

Gas \_\_\_\_\_

Oil \_\_\_\_\_

Total Depth 4377

## PRODUCTION

1st 24 hrs. Nat. \_\_\_\_\_

1st 24 hrs. after shot \_\_\_\_\_

Gas \_\_\_\_\_ Cu. Ft.

Dry Hole \_\_\_\_\_

Abandoned \_\_\_\_\_

Date

MAR 12 1941 19

S. J. LEWIS Scout

Map No. 4/ Sec. 28 Twp. 26 R. 9WWell No. 1 WoodsonBay Petroleum CompanyFIRST REPORT Contractor

## SECTION PLAT


C E L N E N W

660 Ft. from N. Line

\_\_\_\_\_ Ft. from S. Line

330 Ft. from E. Line

\_\_\_\_\_ Ft. from W. Line

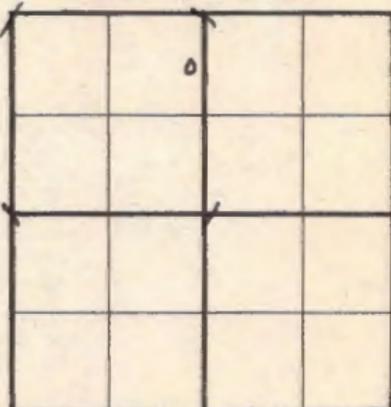

WILDCAT

Location X

Rig up \_\_\_\_\_

Drilling and Remarks:

## RECORD

Cased \_\_\_\_\_ in., \_\_\_\_\_ ft.

Sand \_\_\_\_\_

Gas \_\_\_\_\_

Oil \_\_\_\_\_

Total Depth \_\_\_\_\_

## PRODUCTION

1st 24 hrs. Nat. \_\_\_\_\_

1st 24 hrs. after shot \_\_\_\_\_

Gas \_\_\_\_\_ Cu. Ft.

Dry Hole \_\_\_\_\_

Abandoned \_\_\_\_\_

Date

JAN 29 1941 19S. J. LEWIS Scout