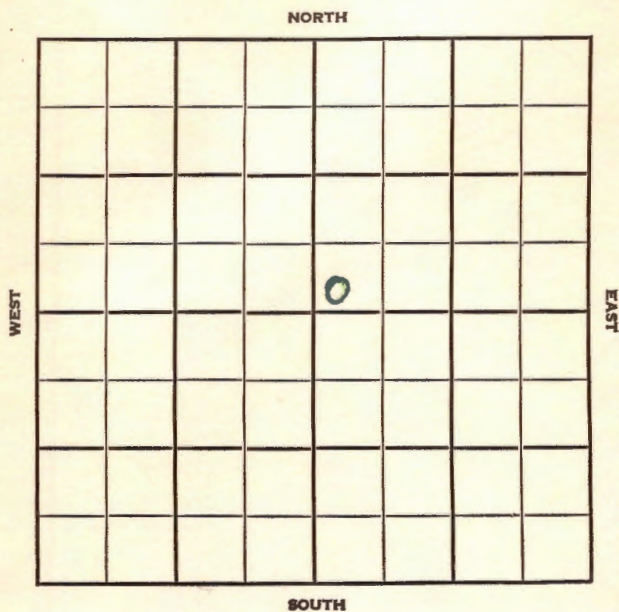


Section 32 Township 26S Range 9WWell No. 1 FosterCompany Appleman

Reno

KANSAS

SEC.	TWP.	R.
32	26S	9W

WELL NO.

#1 Foster

FARM

COMPANY

Appleman

CONTRACTOR

Murfin


Wildcat

_____ Ft. from N. Line

_____ Ft. from S. Line

_____ Ft. from E. Line

_____ Ft. from W. Line

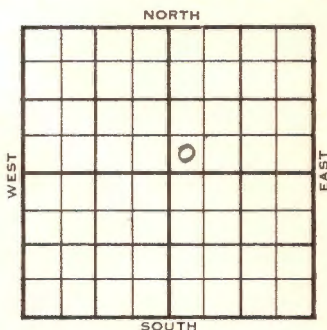

SW SW NE
DS -NE/4
Texas- AC

1955

ELEVATION

1730'

REPORT

7/6

Loc.

8/3

Comm: 7-7-55

8 5/8" @283/200 DST 3946-75 open 2 hr
gas to surface in 3 min, 1,700 mcfg
Rec. 420' muddy wtr. 1440# DST 4208-
14 open 1 hr. Rec. 58' muddy oil spks
800/20" DST 4207-20 open 20 min Rec.
2300' sw, 1120# TD 4406 D&A

Dg.	3285	3287	1557
Bl	3401	3403	1673
L.	3412	3428	1608
M.	3943	3940	2210
K.	4024	4022	2292
V.	4205	4205	2475
S.	4292	4295	2565
A.		4387	2657
TD		4406	

ABANDONED

County **Reno** Elev. _____
 Sec. **32** Twp. **26S** Rge. **9W**
 Company **Appleman**
 Farm Name **Foster** No. **1**

TOPS	DEPTH	LOG	DATUM
Anh.			
Tr.			
H.			
Tr.			
Dg.			
Bl.			
L.			
K.C.			
B.K.C.			
Ce.			
C.			
M.			
M.			
K.			
Mz.			
Me.			
V.			
S.			
S.			
A.			
R.			
Pe.			
G.			
T.D.			

Loc. in Sec. _____

SW SW NE
DS - NE/4

Texas - AC

Geol. _____

Contr. _____

Murfin

Pool **W.C.**

FIRST REPORT

JUL 6 '35

Date Comm. **Loc.**

[Handwritten signature]

County	Reno		Elev.	1730
Sec.	32	Twp.	26	Rge. 9W
Company	Appleman			
Farm Name	Foster			No. 1

TOPS	DEPTH	LOG	DATUM	Loc. in Sec.
Anh.				SW SW NE
Tr.				
Dg.	3285	3287	1557	
Bl.	3401	3403	1675	
L.	3412	3428	1698	
K.C.				Geol.
B.K.C.				Contr.
Ce.				Murfin
C.				Pool
M.	3943	3940	2210	Wildcat
M.				
K.	4024	4022	2292	
Mz.				
Mq.				
V.	4205	4205	2475	
S.	4292	4295	2565	
S.				
A.		4387	2657	
R.				
Pe.				
G.				
TD.		4406		

ABANDONED

Date Comm.	7-7-55	AUG 3 1955
8 5/8" @ 283/200 DST 3946-75		
open 2 hr. gas to surface in 3 min.		
1,700 mcfg Rec. 420' muddy wtr. 1440#		
DST 4208-14 open 1 hr. Rec. 58'		
muddy oil spks 800/20" DST 4207-20		
open 20 min. Rec. 2300' SW 1120#		
TD 4406		

D & A