


Map No. KANSAS Sec. 10 Twp. 26 R. 9W

Well No. Lee Farm  
Shell Pit Company

NORTH

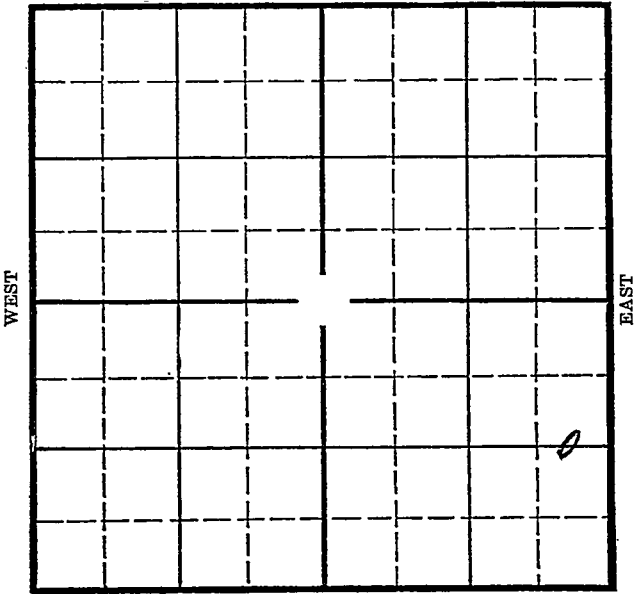

SOUTH

Location \_\_\_\_\_

Drilling Remarks \_\_\_\_\_

\_\_\_\_\_

\_\_\_\_\_

Rig Up \_\_\_\_\_

Drilling Remarks \_\_\_\_\_

\_\_\_\_\_

\_\_\_\_\_

RECORD

Cased \_\_\_\_\_ in. \_\_\_\_\_ ft.

Sand \_\_\_\_\_

Gas \_\_\_\_\_

Oil \_\_\_\_\_

Total Depth \_\_\_\_\_

PRODUCTION

1st 24 hrs. Nat. \_\_\_\_\_

1st 24 hrs. after shot \_\_\_\_\_

Gas \_\_\_\_\_ cu. ft.

Dry Hole \_\_\_\_\_

Abandoned \_\_\_\_\_

Reno

Map No. KANSAS Sec 10 Twp. 26 R. 9W

Well No. 1- Lee Farm \_\_\_\_\_  
Shell Pet Company \_\_\_\_\_


1320 Ft. from N. Line

\_\_\_\_\_ Ft. from S. Line

330 Ft. from E. Line

\_\_\_\_\_ Ft. from W. Line

Elev. 1685

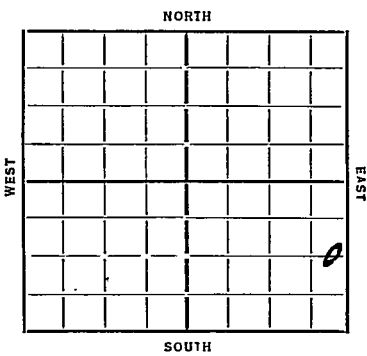

REPORT

~~11/20~~  
 11/20 B.R.  
 11/29 Run Rot  
 12/6 dly 1885  
 12/13 T/C 3349 to 3390-95  
 Coring 3400  
 12/19 dly 4025 Top Chert 3880  
 12/26 Top Viola 4145  
 Cored 4145-50 TD No Oil  
 1/2/36 TD 4150 flowed 661 Oil 4 hrs  
 SD for tanks  
 1/10 TD 4158  
 flowed 3604 Bbls Oil 24 hrs  
 with 1,360,000 Gas  
 Many acidine  
 1/15 Viola 4145  
 TD 4158  
 1000 acid  
 1,360,000 Gas  
 5646 Bbls flow.

COMPLETED

Map No. 41 Sec. 10 Twp. 26 R. 9W

Well No. 1-See

Shell Pet Company

Contractor

**COMPLETE**

SECTION PLAT

1320 Ft. from N. Line

..... Ft. from S. Line

330 Ft. from E. Line

..... Ft. from W. Line

			0

Location.....

Rig up.....

Drilling and Remarks:

1000 and

1,360,000 gas

5646 bbls

flow

RECORD

Cased..... in., ..... ft.

Sand Viola 4145

Gas.....

Oil.....

Total Depth 4150

PRODUCTION

1st 24 hrs. Nat.....

1st 24 hrs. after shot.....

Gas..... Cu. Ft.

Dry Hole.....

Abandoned.....

Date

1-15-36 192.....

ORVAL MANES, Y

Scout

KANSAS

Map No. 41 Sec. 10 Twp. 26 R. 9W

Well No. 1-See

Shell pet. Company

Contractor

FIRST REPORTS

SECTION PLAT

1320 Ft. from N. Line

..... Ft. from S. Line

330 Ft. from E. Line

..... Ft. from W. Line


Location.....

Rig up.....

Drilling and Remarks:

BR

RECORD

Cased..... in., ..... ft.

Sand.....

Gas.....

Oil.....

Total Depth.....

PRODUCTION

1st 24 hrs. Nat.....

1st 24 hrs. after shot.....

Gas..... Cu. Ft.

Dry Hole.....

Abandoned.....

Date

11-20-35 192.....

ORVAL MANNING PUCK

Scout