


Reno **KANSAS**

Section 10 Township 26 Range 9-W


Well Number 3 Lee

Company Shell

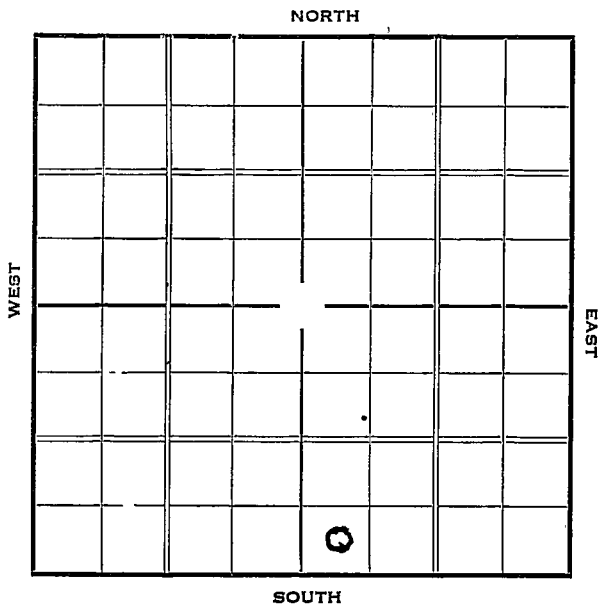

Sec. 10 Twp. 26 R. 9Well No. #3 Lee Farm
Shell Company Ft. from N. Line330 Ft. from S. Line Ft. from E. Line330 Ft. from W. Line

Elev. 1675

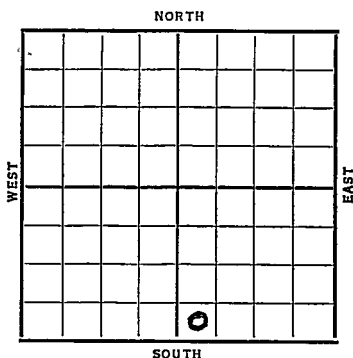

Date	REPORT
1937	
4/7	Rig
4/16	Rigging up
4/23	10" @ 314'. Drlg. 1517'.
4/30	Drlg. 3072'.
5/7	Drlg. 3800'.
5/14	Chat 3872'. Viola 4136'.
	7" @ 4136'. T.D. 4137'.
	WOC.
5/19	7" @ 4136'.
	Viola 4136'.
	T.D. 4139'.
	1000 acid.
	Flowed 703½ bbls. 6 hrs.
	Potential 2659 bbls.
	COMPLETED

KANSAS*Revd.*Map No. 41 Sec. 10 Twp. 26 R. 9W.Well No. 3 Lee.Shell Company

Contractor

SECTION PLAT Ft. from N. Line330 Ft. from S. Line Ft. from E. Line330 Ft. from W. Line**VIRG. REPT.**

Location Rig up

Drilling and Remarks:

Rig

○

RECORDCased in., ft.Sand Gas Oil Total Depth **PRODUCTION**1st 24 hrs. Nat. 1st 24 hrs. after shot Gas Cu. Ft.Dry Hole Abandoned

Date

APR 7 1931

S. J. LEWIS Scout

KANSAS

Map No. 41 Sec. 10 Twp. 26 R. 9 WWell No. 3-LeeShell Company

Contractor

COMPLETED

SECTION PLAT

Ft. from N. Line

330 Ft. from S. Line

Ft. from E. Line

330 Ft. from W. Line

Location _____

Rig up _____

Drilling and Remarks:

1000 acid.flowed 703 1/2 hrsPost2659

RECORD

Cased 7 in., 4136 ft.Sand Viola 4136

Gas _____

Oil _____

Total Depth 4139

PRODUCTION

1st 24 hrs. Nat. _____

1st 24 hrs. after shot _____

Gas _____ Cu. Ft.

Dry Hole _____

Abandoned _____

Date

MAY 19 1937 19

H. D. Hatfield

Scout