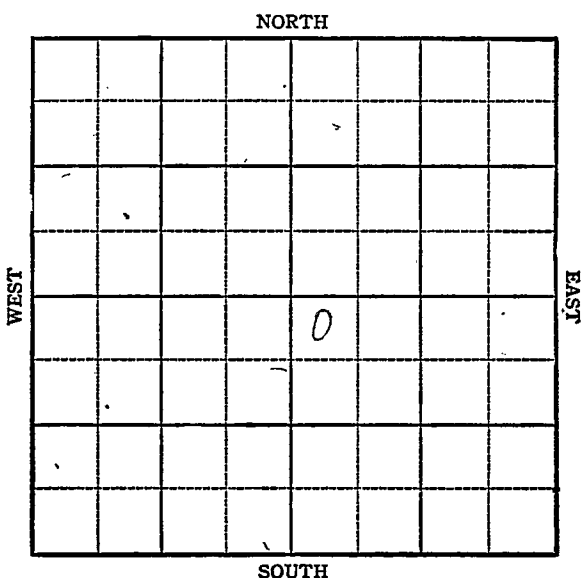



KANSAS

Kearny

Section 9 Township 26 Range 35WWell No. #1 WhiteCompany Helmerick & Payne

Sec. 9 Twp. 26 R. 35WWell No. #1 White Farm
Helmerick & Payne Company

Hugoton

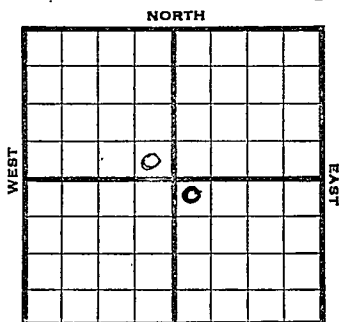100 Ft. from N. Line Ft. from S. Line Ft. from E. Line100 Ft. from W. Line

Kearny NW SE Elev. 3041

R E P O R T

1944

11/29 RUR
12/6 Drlg. 350
12/14 Drlg. 470'
12/21 10" @ 776'
Drlg. 1935'
12/29 5" @ 2724'
TD 2738' RUST

1945
1/3

" " "

1/10 " " "

1/17 " " "

1/26 " " "

1/31 " " "

2/7 " " "

2/14 " " "

2/21 " " "

2/28 " " "

3/7 " " "

3/14 1000 acid

3/23 " "

3/29 6000 acid.

4/5 10500 acid

4/12 " "

4/20 " "

OVER

Pool Name HugatonMap No. 111 Sec. 9 Twp. 26 R. 35WWell No. 1 WhiteHeImerick & Payne

Company

FIRST REPORT

Contractor

NW SE

SECTION PLAT

100

Ft. from N. Line

Ft. from S. Line

Ft. from E. Line

100

Ft. from W. Line

		o	

Kearny

RECORD

Location

Cased _____ in. _____ ft.

Rig up

Sand _____

Drilling and Remarks:

Gas _____

R U R

Oil _____

Total Depth _____

PRODUCTION

1st 24 hrs. Nat. _____

1st 24 hrs. after shot _____

Gas _____

Cu. Ft. _____

Dry Hole _____

Abandoned _____

Date

NOV 29 1944

19

S. J. LEWIS

Scout

KANSAS

Pool Name HugotonMap No. 110 map Sec. 9 Twp. 26 R. 35WWell No. 1 WhiteHelmerick & Payne

Company

COMPLETED

Contractor

NW SE

E1804/
SECTION PLAT100 Ft. from N. Line Ft. from S. Line Ft. from E. Line100 Ft. from W. Line

		0	

Kearny County

Location Rig up

Drilling and Remarks:

5" @ 272427500 acid6, 540, 008 Gas

RECORD

Cased in., ft.Sand Gas Oil Total Depth 2295

PRODUCTION

1st 24 hrs. Nat. 1st 24 hrs. after shot Gas Cu. Ft.Dry Hole Abandoned

Date

JUL 3 1945 19S. J. LEWIS Scout