


Section 1 Township 27 Range 38W

Well No. #1 Beymer "G"

Company Stanolind

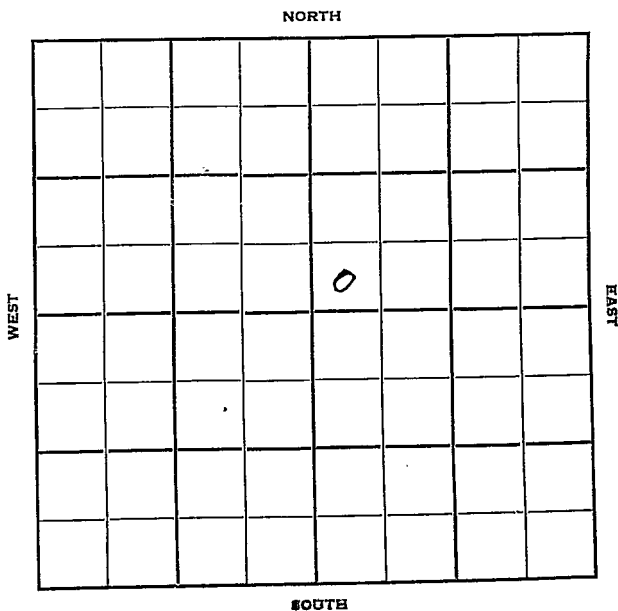

Sec. 1 Twp. _____ R. _____

Well No. #1 Beymer "G" Farm _____

Stanolind Company _____

Hugoton Pool Contractor _____


_____ Ft. from N. Line

150' Ft. from S. Line

_____ Ft. from E. Line

300' Ft. from W. Line

SW NE

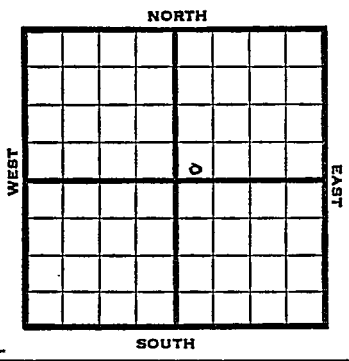

Gas Well

1950 Elev 3089 REPORT

9/13 Location

10/11 Spud 9-15-50
 10" @ 565
 7" @ 2501
 TD 2555
 Her 2342-57
 Win 2379
 Towanda 2446-76
 Ft. Riley 2501-30
 36/2337-57, 84/2362-76, 108/2415-33
 168/2470-98
 20,000 total A
 Comp 5,450,000 gas
 open flow 413#
 Completed
COMPLETED

