


Section 1 Township 27 Range 37-W

Well No. #1 Moore

Company Cities Service

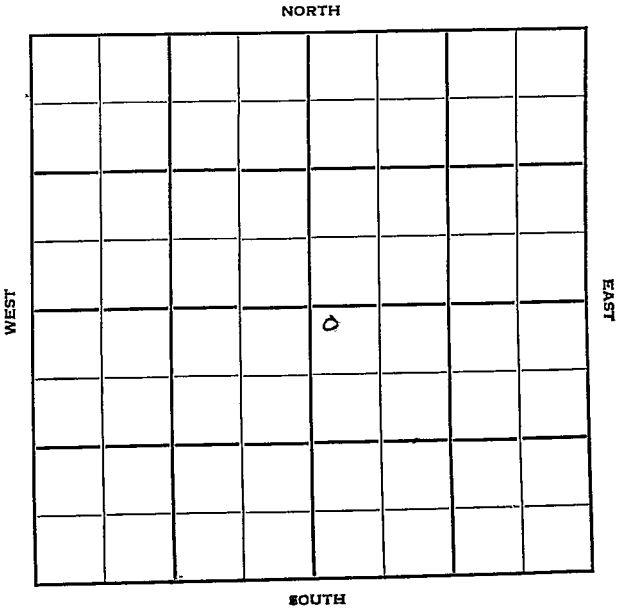

Grant

KANSAS

Sec. 1 Twp. 27 R. 37W

Well No. #1 Moore Farm

Cities Service

Company

Contractor

Hugoton Pool


100' Ft. from N. Line

Ft. from S. Line

Ft. from E. Line

100' Ft. from W. Line

NW SE

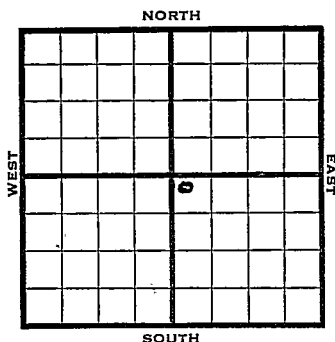

1950

Elev 3100 REPORT

8/16 RUR

10/18 Spud 8-15-50

8" @ 520

5" @ 2679

TD 2680

Her 2434

Krider 2462

Win 2516

Ft. Tiley 2578

140/2628-56 1500 A

70/2464-78 90/2482-2500

30/2580-2606

3000 A

Comp 14,800,000 gas

Completed

COMPLETED



Sec. 1 (Blk. 27 (Sur. 37 Map No. _____
(Twp.) (Rge.)

Well No. 1 Farm Moore

Elev.	Location	NW SE
-------	----------	-------

FIRST REPORT

100 Ft. From N Line SE

100 Ft. From W Line Quarter

1st. Report AUG 16. 1950

Completion

Remarks

Spudding Date


Drlg. Data Hugoton Pool

R U R

J. E. TYRA

AUG 21 1950

Scott Cards	
Land Small Map	
Land Wall Map	
Tracings	
Franchise Map	
..... Map	

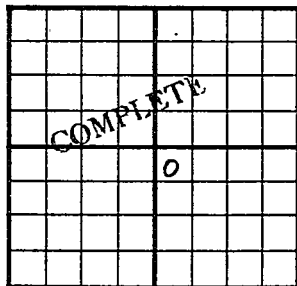County Grant State KansasSec. 1 (Blk.
Twp.) 27 (Sur.
Rge.) 37W Map No.Operator Cities ServiceWell No. 1 Farm MooreElev. 3100 Location NW SE100 Ft. From N Line SE100 Ft. From W Line Quarter

1st. Report

Completion OCT 18 1950Remarks Hugoton PoolSpudding Date 8-15-50Drlg. Data Gas well TD 26808" @ 520 5" @ 2679 TD 2680Her. 2434 Krider 2462 Win. 2516Ft. Riley 2578 140/ 2628-56 1500A70/ 2464-78 90/ 2482-2500 30/ 2580-260630000 A Comp. 14,800,000 gas

J. E. TYRA

Scout Cards 7 W
Land Small Map
Land Wall Map 3
Tracings
France Map
Pierce Map
Misc.

Oct 25 1950

Drig. Data