

KANSAS

Grant

36W

Sec. 1 Twp. 27 R. 36W

Well No. #1 Moore Farm

Magnolia Company

Hugoton Pool


330' Ft. from N. Line

_____ Ft. from S. Line

_____ Ft. from E. Line

330' Ft. from W. Line

NW SE

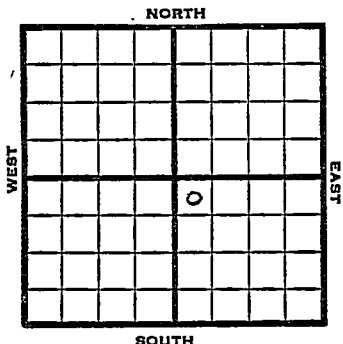

1949 Elev 3084' REPORT

- 3/23 Location
- 3/30 10" @ 831'
Drlg. 1600'
- 4/6 Drlg. 2585'
- 4/12 TD 3770'
7" @ 2769'
- 4/20 "
- 4/27 "
- 5/4 480 shots 2539-2728
Acid 2700
- 5/10 7000 acid
- 5/18 I
- 5/25 TD 2770'
7" @ 2769'
Perf 34000 acid
12,110,000 Gas
393# R Pr.
Comp

COMPLETED

Kansas

27

36W

Map No. _____ Sec. 1 Twp. _____ R. _____

Well No. 1 Moore

Magnolia Company

FIRST REPORT Contractor _____

NW SE

SECTION PLAT

330 Ft. from N. Line

_____ Ft. from S. Line

_____ Ft. from E. Line

330 Ft. from W. Line

		o	

Grant County

Location x

Rig up _____

Drilling and Remarks:

RECORD

Cased _____ in., _____ ft.

Sand _____

Gas _____

Oil _____

Total Depth _____

PRODUCTION

1st 24 hrs. Nat. _____

1st 24 hrs. after shot _____

Gas _____ Cu. Ft.

Dry Hole _____

Abandoned _____

Date

MAR 23 1949

S. I. LEWIS

Scout

Map No. _____ Sec. 1 Twp. 27 R. 36W

Well No. 1 Moore

Magnolia Company

COMPLETE Contractor _____

NW SE

E13084

SECTION PLAT

330 Ft. from N. Line

_____ Ft. from S. Line

_____ Ft. from E. Line

330 Ft. from W. Line

		0	

Grant County

Location _____

Rig up _____

Drilling and Remarks:

7" 02765
Perf.
34000 acid
12, 110, 000 gal
393 # RB

RECORD

Cased _____ in., _____ ft.

Sand _____

Gas _____

Oil _____

Total Depth 2770

PRODUCTION

1st 24 hrs. Nat. _____

1st 24 hrs. after shot _____

Gas _____ Cu. Ft.

Dry Hole _____

Abandoned _____

Date

MAY 25 1949. 19

S. J. LEWIS

Scout