


Section 1 Township 27 Range 39 W

Well No. # 1 Molz "D"

Company Stanolind

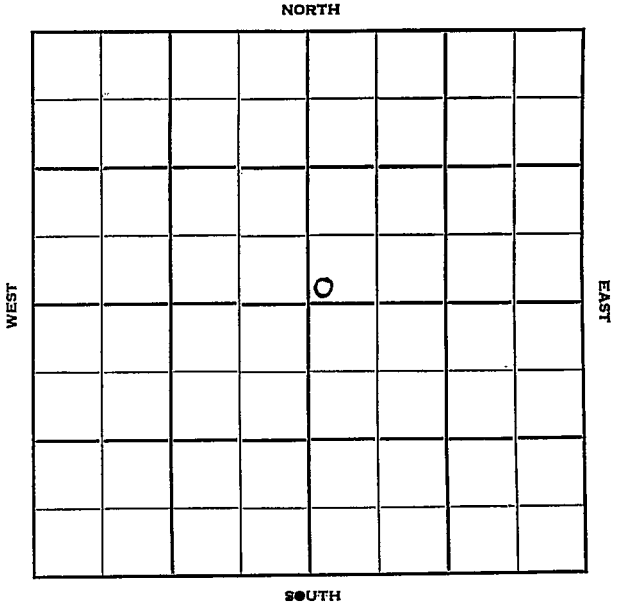

Sec. 1 Twp. 27 R. 39W

Well No. #1 Molz "D" Farm _____

Stanolind Company

Hugoton Pool Contractor


_____ Ft. from N. Line

150 Ft. from S. Line

_____ Ft. from E. Line

150 Ft. from W. Line

SW NE

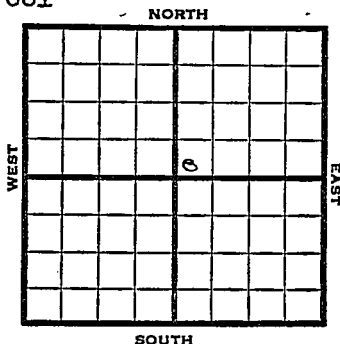

1952 Elev. 3201' REPORT

2/20 Spud 2-15-52
10" @ 587' dlr.g

3/5 NR

3/12 DO to 2576 2500 A 48/2361-69
30/2371-76 60/2378-88
12/2392-94 24/2416-20 24/2430-34
78/2441-54 24/2460-64
66/2475-86 60/2490-2500
24/2504-08 24/2516-20
20,000 A

3/19 No report

4/2 Spud 2-15-52
Gas Well TD 2576
10" @ 587'
Win. 2410 Ft. Riley 2475
TD 2576 7" @ 2543 2500 A
48/ 2361-69 30/ 2371-76
60/ 2378-88 12/ 2392-94
24/ 2416-20 24/ 2430-34
78/ 2441-54 24/ 2460-64
66/ 2475-86 60-/ 2490-2500
24/ 2504-08 24/ 2516-20
22500 A Comp. 11,389,000 gas

COMPLETED

County Stanton State KansasSec. 1 (Blk. Twp.) 27 (Sur. Rge.) 39W Map No.Operator StanolindWell No. 1 Farm Molz "D"Elev. 3201 Location SW NE

			0		
COMPLETE					

150 Ft. From S Line NE

150 Ft. From W Line Quarter

1st. Report

Completion APR 2 1952Remarks Hugoton PoolSpudding Date 2-15-52Drlg. Data Gas well TD 257610" @ 587 Win. 2410 Ft. Riley 2475TD 2576 7" @ 2543 ~~DD 2576~~ 2500 A48/ 2361-69 30/ 2371-76 60/ 2378-8812/ 2392-94 24/ 2416-20 24/ 2430-3478/ 2441-54 24/ 2460-64 66/ 2475-8660/ 2490-2500 24/ 2504-08 24/ 2516-2022500 A Comp. 11,389,000 gas