


Section 1 Township 27 Range 12W

Well No. 1 Montgomery

Company C R A

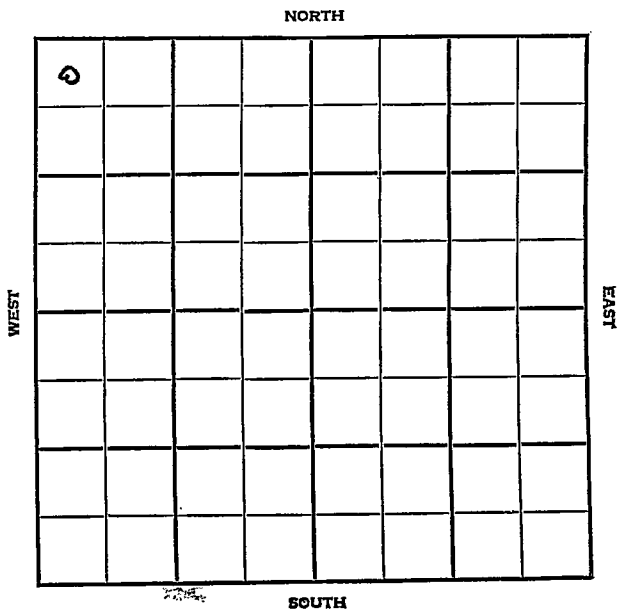

Pratt

KANSAS

SEC.	TWP.	R.
1	27	12W ✓

WELL NO.

1 Montgomery

FARM

COMPANY

C R A

CONTRACTOR

Shaffer-Contr.

Wildcat

NORTH

330 Ft. from N. Line

Ft. from S. Line

Ft. from E. Line

330 Ft. from W. Line

WEST

EAST

SOUTH

NW NW NW

Arb. Test

1954

ELEVATION

1866

REPORT

6/2

Location

6/9

8" @ 355'

rlg. 2930'

6/23

Spudding 6-1-54

D & A

TD 4560

8" @ 355'

TOR 3487 Doug. 3505 Br. Line 3667

Lans. 3681 Miss. 4121

DST 4122-32 open 1 hr. Rec. 30'

so & gcm 1260#

DST 4132-60 open 1 hr. Rec. 200' gcm

145' wtr. 1640#

Viola 4340 Simp. 4443 Arb. 4524

TD 4560

D&A

ABANDONED

County Pratt State Kansas

Sec. 1 (Blk.) 27 (Sur.) 12W Map No.

Operator CRA

Well No. 1 Farm Montgomery

Elev. _____ Location N1/2 N1/2 N1/2

0			

FIRST REPORT

330 Ft. From W Line N1/2

330 Ft. From W Line Quarter

Ist. Report: JUN 2 1954

Completion _____

Remarks Arb. test.

Shaffer - Contr.

Spudding Date _____

Drlg. Data Wildcat

Location _____

Scout Cards

Land Small Map

Land Wall Map

Tracings

France Map

Pierce Map

Misc.

DM

63

JUN 5 1954

Orig. Date

County Pratt State Kansas

Sec. 1 (Blk.) 27 (Sur. Rge.) 12W Map No.

Operator C R A

Well No. 1 Farm Montgomery

Elev. 1866 Location NW NW NW

o					

330 Ft. From N Line NW

330 Ft. From W Line Quarter

1st. Report

Completion JUN 23 1954

Remarks Wildcat

Shaffer - Contr.

Spudding Date 6-1-54

Drlg. Data D & A TD 4560

8" @ 355 Tor. 3487 Doug. 3505

Br. lime 3667 Lans. 3681 Miss. 4121

DST 4122-32 open 1 hr. Rec. 30' so &

gcm 1260# DST 4132-60 open 1 hr.

Rec. 200' gcm 145' wtr. 1640#

Viola 4340 Simp. 4443 Arb. 4524

TD 4560

D & A

R. L.

1954

JUL 1 1954

Scout Cards	_____
Land Small Map	_____
Land Wall Map	_____
Tracings	_____
France Map	_____
Pierce Map	_____
Misc.	_____

DM

3

Orig. Data