

LAUGHLIN-SIMMONS & CO. OF KANSAS, INC.

KW1205785

OIL FIELD SURVEYING  
1337 NORTH MERIDIAN, SUITE 2  
WICHITA, KANSAS 67203

(316) 943-5351

INVOICE NO

12-5-78

DATE

Kingman COUNTY 14 S 27s T 10w R

C NE SE LOCATION

Rupe Oil OPERATOR

1 NO. Dyche FARM

ELEVATION: 1732 gr

DEC 7 1978



Glen N. Rupe  
Box 2273  
Wichita, KS 67201


AUTHORIZED BY: Bill Clements

PHONE # 262-3748

MI 1st of week RUSH\*

SCALE: 2" = 1 Mile

5' rod - 1' wood in  
slightly sloping  
fallow field

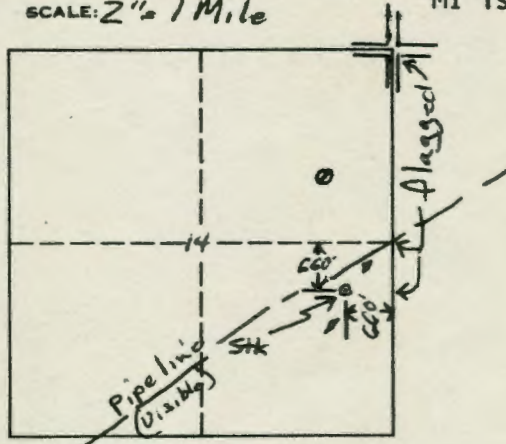

MINIMUM STAKING CHARGE: \$85.00  
(INCLUDES GROUND ELEVATION)  
EXTRA TIME & MILEAGE: \$45.00 \*

ELEVATION CHARGE: \_\_\_\_\_  
TOTAL: \$130.00

(52)

Jon Johnson  
L-S SURVEYOR

Laughlin-Simmons & Co. of Kansas, Inc. is not liable in case of errors and/or omissions.

mailed copy to  
John Cant  
12/7/78