

LAUGHLIN-SIMMONS & CO. OF KANSAS, INC.

OIL FIELD SURVEYING
1337 NORTH MERIDIAN, SUITE 2
WICHITA, KANSAS 67203 (316) 943-5351

KW06187919

INVOICE NO.

6-20-79

DATE

Kingman
COUNTY

13 27s 10w
S T R

C S/2 NE
LOCATION

Rupe Oil Co Inc
OPERATOR

1
NO.

Freeland

FARM

ELEVATION: 1739 gr

JUN 22 1979



Rupe Oil Company, Inc.
P.O. Box 2275
Wichita, Kansas 67201


AUTHORIZED BY: Bill Clement

PHONE #

SCALE: 2" = 1 Mile

MI 8 days

5' wood stake in level plowed field

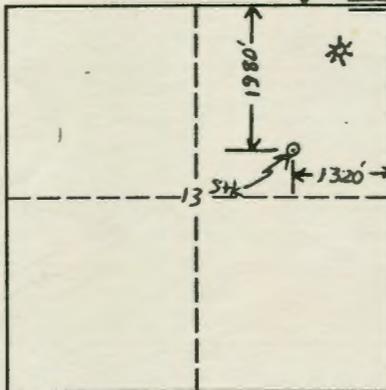

\$85.00

MINIMUM STAKING CHARGE: (INCLUDES GROUND ELEVATION)

EXTRA TIME & MILEAGE:

ELEVATION CHARGE:

TOTAL:

\$85.00

Thank You,

Jan Schuder

LS SURVEYOR

Laughlin-Simmons & Co. of Kansas, Inc. is not liable in case of errors and/or omissions.