

Kingman

KANSAS

Section 24 Township 27 Range 10 ~~10~~ 10 ~~10~~ 10

Well No. 1 Bayer

Company Anderson-Prichard

NORTH

WEST

EAST

	0						

SOUTH

Kingman

KANSAS

Sec. 24 Twp. 27 R. 10W

Well No. #1 Bayer Farm

Anderson-Prichard Company

B & B Drlg.- Contr Contractor

Dresden Pool


330' Ft. from N. Line

Ft. from S. Line

Ft. from E. Line

990' Ft. from W. Line

NE NW NW

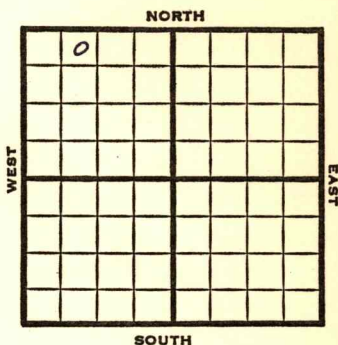

1951

Elev. 1753' REPORT

7/25

Spud 7-21-51

8" @288

Drlg. 2175'

8/22

Spud 7-21-51

D&A TD 4322

8" @ 288

Lans. 3500

Br Lime 3498

Lans. 3508

DST 3849-60 opn $\frac{1}{2}$ hr

Rec. 35' so & gcm **Miss 4030**

DST 4030-50 opn 1 hr Rec. 150' o & gcm

Kh 4122

Viola 4316

DST 4315-22 opn 1 hr Rec. 120' gcm

600' sw TD 4322 5" @ 4141

120/4028-40 B/3 go 5 gwph PB 3874

46/3848-56 B/5 gw scum of oil 8 hr.

1000 A B/3/4 bo 10 bw SP 3825

24/3814-18 1000 A S/6 bfph

D&A

ABANDONED

County Kingman State Kansas
 Sec. 24 (Blk.) 27 (Sur.) 10W Map No.
 (Twp.) (Rge.)
 Operator Anderson-Prichard
 Well No. 1 Farm Bayer
 Elev. _____ Location NE NW NW

0							

FIRST REPORT

330 Ft. From N Line NW
990 Ft. From W Line Quarter
 1st. Report JUL 25 1951

Completion _____

Remarks _____

B & B Drlg. - Contr.Spudding Date 7-21-51

Drlg. Data _____

Dresden Pool8" @ 288 drlg. 2175

J. E. TYRA

J. E. TYRA