


Section 28 Township 27 Range 10W

Well No. #1 Henry Gibbons

Company Solar Oil

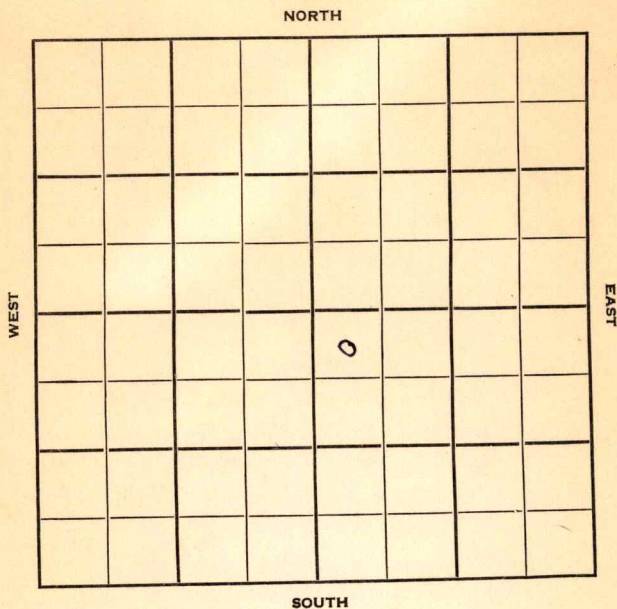

Kingman

KANSAS

Sec. 28 Twp. 27 R. 10W

Well No. #1 Henry Gibbons Farm

Solar Oil Company

B & M Drlg. Contractor

Wildcat

330 Ft. from N. Line


Ft. from S. Line

Ft. from E. Line

330 Ft. from W. Line

SE $\frac{1}{4}$ NW NW SE

Amerada \$5000

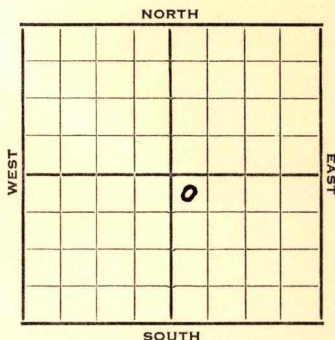

1952 Elev. 1652' REPORT

10/29 MIT

11/5 8" @ 504'

Drlg. 2630'

11/12 Douglas 3327' Br li 3442' Lans. 3455'
Miss 3956'

DST 3970-84' TD

11/19 Spud 10-28-52

D&A

TD 4435'

8" @ 504'

Doug. 3327, Br. lime 3442,

Lans. 3455, Miss 3956

DST 3970-84, opn 2 hrs., rec.

45' socsw 55#

DST 3971-4002, opn 2 hrs., rec.

85' sw 118#

Kh. 4042, Viola 4234

DST 4234-40, opn 2 hrs., rec.

70' gas, 50' so & gcm, 92#

DST 4236-50, opn 2 hrs., rec.

70' wtr 70' gas, 130#

Simp. 4313

DST 4334-45, opn 2 hrs., rec.

75' gas, 285' wtr. 1430#

Arb. 4399

TD 4435

D&A

ABANDONED

J. G. McGEHEE

County Kingman State Kansas
 Sec. 28 (Blk.) 27 (Sur.) 10W Map No.
 Operator Solar Oil
 Well No. 1 Farm Henry Gibbons
 Elev. 1652 Location NW NW SE



330 Ft. From N Line SE
330 Ft. From W Line Quarter
 1st. Report
 Completion NOV 19 1952
 Remarks Wildcat
B & M Drlg. - Contr.
 Spudding Date 10-28-52

Drlg. Data D & A TD 4435
8" @ 504 Doug. 3327 Br. lime 3442
Lans. 3455 Miss. 3956 DST 3970-84
open 2 hr. Rec. 45' socsw 55#
DST 3971-4002 open 2 hr. Rec. 85' sw
118# Kh. 4042 Viola 4234 DST 4234-40
open 2 hr. Rec. 70' gas 50' so & gcm
92# DST 4236-50 open 2 hr. Rec. 70' wt
70' gas 130# Simp. 4313 DST 4334-45
open 2 hr. Rec. 75' gas 285' wtr.
1430# Arb. 4399 TD 4435

D & A

J. G. McGEHEE